

Union  
L 20  
4-68

MISSISSIPPI  
BOARD OF WATER COMMISSIONERS  
416 North State Street  
Jackson, Mississippi 39201

**CODED**

WATER WELL DRILLERS LOG

4-17 1968 Clark Bros. Union  
date well completed firm name county well located


LANDOWNER: Ed Bellingsley  
Rt. 4  
(mailing address)  
WELL LOCATION:  
sec. 9 T. 8 N R. 2 E  
1/4 miles SW of New Albany  
(distance) (direction) (nearest town)

Description of formations encountered	from	to
Jumbo Rocks	0	20
Blue Mud	20	60
Rock	60	160
Blue Mud	160	180
Rock & Sand	180	200
	200	260

WELL PURPOSE: Home  
(home, irrigation, municipal, industrial)

- WELL COMPLETION DATA:
- (1) diameter (inches) 4"
  - (2) total depth (feet) 260
  - (3) static water level (feet) 20 below top of ground.
  - (4) casing Metal 84, (material) (depth)  
4 (size) if telescope see back.
  - (5) screen None (length) (depth to top)  
(size) (material)
  - (6) pump 3/4 HP 9 (yield gpm)  
Electric (type power)
  - (7) electric log No (yes or no)  
(organization running log)
  - (8) how well bottom plugged No


**CODED**

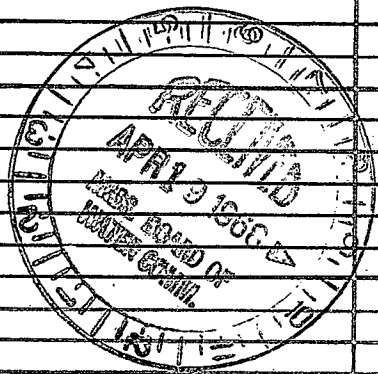

DRILLERS REMARKS:

If well telescopes please sketch and show depths.

GROUND LEVEL

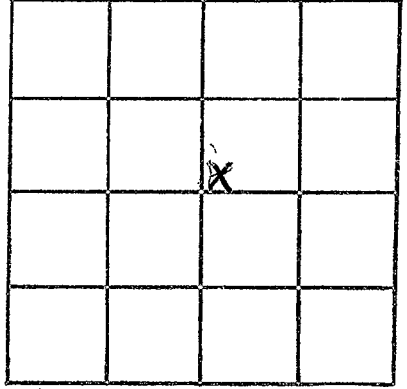

SECTION \_\_\_\_\_

Please indicate well location X.

ADDITIONAL INFORMATION

If more than one screen,  
show locations of each on sketch.