

Union
L21
8-28-68

MISSISSIPPI
BOARD OF WATER COMMISSIONERS
416 North State Street
Jackson, Mississippi 392

CODED

WATER WELL DRILLERS LOG

8-28 1968 Clark Bros Union
date well completed firm name county well located

LANDOWNER:
Freedonia Church
New Albany Rt 4
(mailing address)


description of formations encountered	from	to
Summit Rock	0	20
Blue mud	20	60
Rock & Sand	60	150
	150	200

WELL LOCATION:
sec. 2 T 8 N R 2 E
7 miles SW of New Albany
(distance) (direction) (nearest town)

WELL PURPOSE: none
(home, irrigation, municipal, industrial)

- WELL COMPLETION DATA:
- (1) diameter (inches) 4"
 - (2) total depth (feet) 220'
 - (3) static water level (feet) 40' below top of ground.
 - (4) casing Metal, 85' (material) (depth)
4" (size) if telescope see back.
 - (5) screen None (length) (depth to top)
(size) (material)
 - (6) pump 1 1/2 HP Electric (type power) (yield gpm) 6
 - (7) electric log No (yes or no)
(organization running log)
 - (8) how well bottom plugged No

CODED

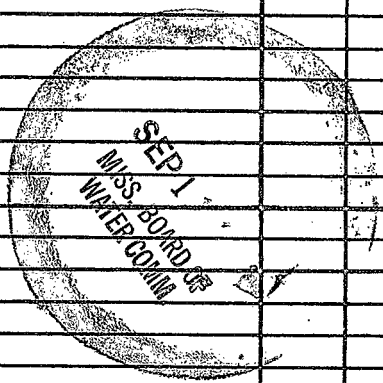

DRILLERS REMARKS:

