

Union  
L23  
8-8-72

MISSISSIPPI  
BOARD OF WATER COMMISSIONERS  
416 North State Street  
Jackson, Mississippi 39201

**CODED**

WATER WELL DRILLERS LOG

8-8 1972 Ed Clark Union  
date well completed firm name county well located

LANDOWNER:  
Mrs. Chady Weedan  
New Albany RT 4  
(mailing address)

description of formations encountered	from	to
	<u>Sandstone</u>	<u>0</u>
<u>Red clay</u>	<u>35</u>	<u>90</u>
<u>Blue sand</u>	<u>90</u>	<u>196</u>
<u>Rock &amp; Sand</u>	<u>196</u>	<u>308</u>

WELL LOCATION:  
sec. 4 T. 8 N. R. 2 E.  
3 miles SW of Ingoma  
(distance) (direction) (nearest town)

WELL PURPOSE: None  
(home, irrigation, municipal, industrial)

- WELL COMPLETION DATA:
- (1) diameter (inches) 4"
  - (2) total depth (feet) 308'
  - (3) static water level (feet) 48' below top of ground.
  - (4) casing metal, 96'  
(material) (depth)  
4"  
(size) if telescope see back.
  - (5) screen None  
(length) (depth to top)  
(size) (material)
  - (6) pump 1 1/2 5  
(HP) (yield gpm)  
Electric  
(type power)
  - (7) electric log no  
(yes or no)  
(organization running log)
  - (8) how well bottom plugged no


**CODED**

SEP 20 1972

DRILLERS REMARKS:

If well telescopes please sketch and show depths.

GROUND LEVEL

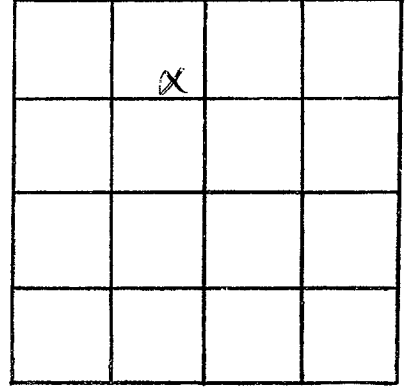

SECTION \_\_\_\_\_

Please indicate well location X.

ADDITIONAL INFORMATION

If more than one screen, show locations of each on sketch.