

MISSISSIPPI  
BOARD OF WATER COMMISSIONERS  
416 North State Street  
Jackson, Mississippi 39201

610.00  
3010  
81070  
**CODED**

**Union**  
**L.25**  
**5-20-73**

**WATER WELL DRILLERS LOG**

520  
date well completed

1973 J. T. Medlin  
firm name

Union  
county well located

LANDOWNER:  
Jerry Jetter  
Ingommon  
(mailing address)


description of formations encountered	from	to
Clay	0	12
sand + rock	12	35
rock + clay	35	13
Blue	25	193
sand	193	230

WELL LOCATION:  
sec. 4 T. 8 N. R. 2 E  
5 miles W of Ingommon  
(distance) (direction) (nearest town)

WELL PURPOSE:  
(home, irrigation, municipal, industrial)

- WELL COMPLETION DATA:
- (1) diameter (inches) 4
  - (2) total depth (feet) 230
  - (3) static water level (feet) 42 below above top of ground.
  - (4) casing (material) P (depth) 200  
(size) If telescope see back.
  - (5) screen (length) (depth to top)  
(size) (material)
  - (6) pump (HP) 1/2 (yield gpm) 5  
(type power)
  - (7) electric log (yes or no)
  - (organization running log)
  - (8) how well bottom plugged

**CODED**

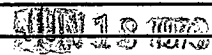


DRILLERS REMARKS:

WIS  
W7

If well telescopes please sketch and show depths.

GROUND LEVEL

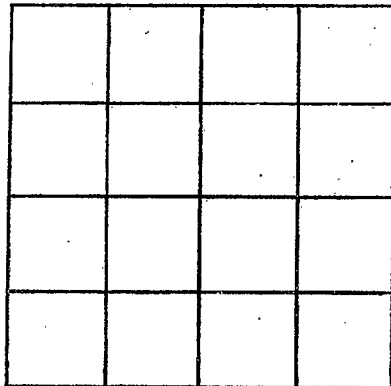

SECTION \_\_\_\_\_

Please indicate well location X.

ADDITIONAL INFORMATION

If more than one screen, show locations of each on sketch.