

UNION
L 2001
8/02/79

MISSISSIPPI
 BOARD OF WATER COMMISSIONERS
 416 North State Street
 Jackson, Mississippi 39201

WATER WELL DRILLERS LOG

8-2-1979 date well completed
 J T Mallin firm name
 UNION county well located

LANDOWNER *Eddie Howdy*
Ingomar Miss
 (mailing address)

description of formations encountered	from	to
Clay	0	18
rock & sand	18	35
Clay	35	85
rock & sand	85	180

WELL LOCATION:
 sec. 3 T 8 N R 2 E
 S W
 9 miles W of Ingomar
 (distance) (direction) (nearest town)

WELL PURPOSE:
 (home, irrigation, municipal, industrial)

WELL COMPLETION DATA:

(1) diameter (inches) 4

(2) total depth (feet) 180

(3) static water level (feet) 35 below top of ground.

(4) casing P 6.5 (material) (depth)
 (size) If telescope see back.

(5) screen (length) (depth to top)
 (size) (material)

(6) pump 1 HP 9 (HP) (yield gpm)
 E (type power)

(7) electric log (yes or no)

(organization running log)

(8) how well bottom plugged

Miss. Board of Water Comm.


AUG 22 1979

DRILLERS REMARKS:

RECEIVED

If well telescopes please sketch and show depths.

GROUND LEVEL

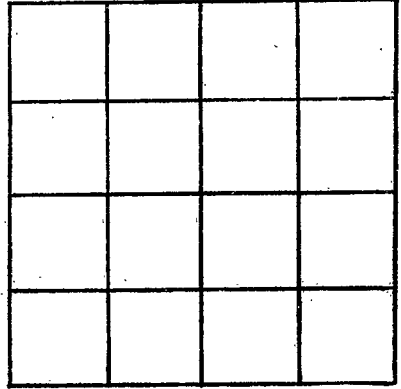

SECTION _____

Please indicate well location X.

ADDITIONAL INFORMATION

If more than one screen, show locations of each on sketch.