

Union  
L 2000  
6-79

MISSISSIPPI  
BOARD OF WATER COMMISSIONERS  
416 North State Street  
Jackson, Mississippi 39201

CODED

WATER WELL DRILLERS LOG

June 19 1979 LEEPER Drilling Union  
date well completed firm name county well located

LANDOWNER: CORNELIUS FARMS  
New Albany Ms.  
(mailing/address)

description of formations encountered	from	to
RED SAND	0	20
Blue clay	30	60
lime rock	60	80
Blue clay	80	140
SAND	140	182

WELL LOCATION:  
sec. 10 T 8 N R 20 E  
S W  
(distance) miles (direction) of (nearest town)

WELL PURPOSE:  
(home, irrigation, municipal, industrial)

- WELL COMPLETION DATA:
- (1) diameter (inches) 4"
  - (2) total depth (feet) 182 FT.
  - (3) static water level (feet) 60 below top of ground.
  - (4) casing PVC 92 (material) (depth)
  - (5) screen 4" (size) if telescope see back. None - OPEN BOTTOM (length) (depth to top)
  - (6) pump 1HP 35 (HP) (material) (yield gpm) 80 gpm (type power)
  - (7) electric log (yes or no) (organization running log)
  - (8) how well bottom plugged


DRILLERS REMARKS:

DEPT. OF NATURAL RESOURCES  
BUREAU OF LAND & WATER RESOURCES

FEB 11 1980  
RECEIVED

If well telescopes please sketch and show depths.

GROUND LEVEL

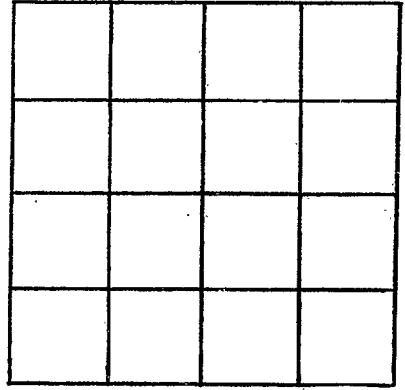

SECTION \_\_\_\_\_

Please indicate well location X.

ADDITIONAL INFORMATION

If more than one screen,  
show locations of each on sketch.