

MISSISSIPPI DEPARTMENT OF NATURAL RESOURCES

Bureau of Land and Water Resources

Southport Mall

P.O. Box 10631

Jackson, Mississippi 39209

WATER WELL DRILLERS LOG

UNION
L 2003
2/25/79
June 25 19 79
 date well completed

LEEPER
 firm name

UNION
 county well located

LANDOWNER:
CORNELIUS FARMS
INGOMAR, MS
 (mailing address)

description of formations encountered	from	to
Top clay	0	20
Top clay	0	20
Red sand	20	60
Blue clay	60	95
Sand & Rock	95	182

WELL LOCATION:
9 sec. 18 T. 8 N. R. 3 E.
1 miles West of INGOMAR
 (distance) (direction) (nearest town)

WELL PURPOSE:
 (home, irrigation, municipal, industrial)


WELL COMPLETION DATA:

- (1) diameter (inches) 4"
- (2) total depth (feet) 182'
- (3) static water level (feet) 60 below top of ground
- (4) casing PVC 90
 (material) (depth)
- if telescope see back
 (size)
- (5) screen NONE
 (length) (depth to top)
- (size) (material)
- (6) pump 1 10
 (HP) (yield gpm)
- Elec
 (type power)
- (7) electric log NO
 (yes or no)
- (organization running log)
- (8) how well bottom plugged OPEN

DEPT. OF NATURAL RESOURCES
 BUREAU OF LAND & WATER RESOURCES

FEB 24 1981


RECEIVED

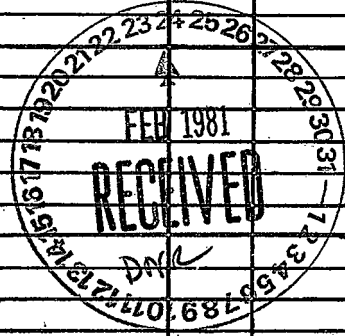

DRILLERS REMARKS:

If well telescopes please
sketch and show depths.

GROUND LEVEL

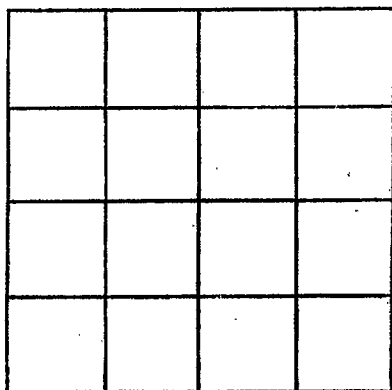

SECTION _____

Please indicate well location X.

ADDITIONAL INFORMATION

If more than one screen,
show locations of each on sketch.