

~~4/11~~

Union
M 11.
12-20-68

MISSISSIPPI
BOARD OF WATER COMMISSIONERS
416 North State Street
Jackson, Mississippi 39201

CODED
CODED
Union
Pontotoc

WATER WELL DRILLERS LOG

Dec. 20 1968 J. W. Wells & Sons Pontotoc
date well completed firm name county well located

LANDOWNER:
Price Cabinet Shop
Myrtle, Miss.
(mailing address)
WELL LOCATION:
sec. 6 T. 8 N R. 3 E
5 miles N of Eum
(distance) (direction) (nearest town)

description of formations encountered	from	to
Red clay & sand	0	20
Red sand	20	45
oily Blue mud	45	55
Blue mud	55	115
Water sand	115	185
Blue mud & sand	185	200

WELL PURPOSE: Home
(home, irrigation, municipal, industrial)

WELL COMPLETION DATA:
(1) diameter (inches) 4
(2) total depth (feet) 200
(3) static water level (feet) 60 below above top of ground.
(4) casing steel 63 (material) (depth) 4" (size) If telescope see back.
(5) screen none (length) (depth to top) (size) (material)
(6) pump 3/4 6 (HP) (yield gpm) Electric (type power)
(7) electric log no (yes or no)
(organization running log)
(8) how well bottom plugged

CODED
CODED


APP
APR 1 1969

MISS. BD. OF
WATER COM.

DRILLERS REMARKS:

If well telescopes please sketch and show depths.

GROUND LEVEL

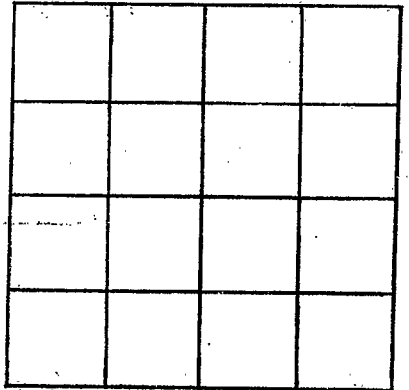

SECTION 6

Please indicate well location X.

ADDITIONAL INFORMATION

If more than one screen,
show locations of each on sketch.