

Union

MISSISSIPPI  
BOARD OF WATER COMMISSIONERS

CODED

416 North State Street

Jackson, Mississippi 39201

CODED

WATER WELL DRILLERS LOG

M 12

8-4-68

Aug 4 1968

JET Mullins

Union

date well completed

firm name

county well located

LANDOWNER:

W. D. Woods  
New Albany

(mailing address)

description of formations encountered

from

to

WELL LOCATION:

sec. 2 T. 8 N. R. 30 E. W. 3  
(distance) miles (direction) of Bacon  
(nearest town)

Red Clay	0	18
Black sand	18	36
Blue clay	36	50
Red sand	50	83
Blue clay	83	103
Black sand	103	125
Black clay	125	165
Black sand	165	195
Blue clay	195	210

WELL PURPOSE:

(home, irrigation, municipal, industrial)

WELL COMPLETION DATA:

- (1) diameter (inches) 4"
- (2) total depth (feet) 200
- (3) static water level (feet) 135 (below top of ground)
- (4) casing Plastic 200 (material) (depth)
- (5) screen 40 160 (length) (depth to top)
- (6) pump 1/2 10 (HP) (yield gpm)
- (7) electric log (yes or no)
- (8) how well bottom plugged

CODED


JUN 27 1969

MISS. BD. OF  
WATER COMM.

DRILLERS REMARKS

If well telescopes please sketch and show depths.

GROUND LEVEL

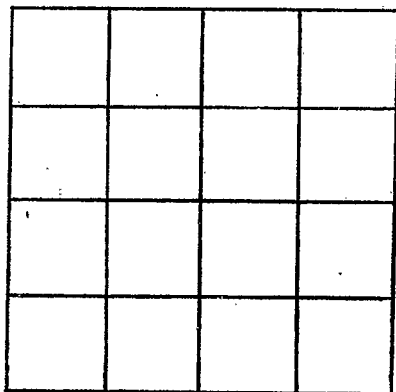

SECTION \_\_\_\_\_

Please indicate well location X.

ADDITIONAL INFORMATION

If more than one screen, show locations of each on sketch.