

MISSISSIPPI
BOARD OF WATER COMMISSIONERS
416 North State Street
Jackson, Mississippi 39201

CODED

WATER WELL DRILLERS LOG

| |
|---------|
| Union |
| M15 |
| 3-18-70 |

3-18 1970 Clark Bros. Union
 date well completed firm name county well located

LANDOWNER:
James Carson
RT-1 - New Albany
 (mailing address)

| description of formations encountered | from | to |
|---------------------------------------|----------|-----|
| | red clay | 0 |
| rock & sand | 15 | 75 |
| blue mud | 75 | 205 |
| rock & sand | 205 | 330 |

WELL LOCATION:
 sec. 16 T. 8 N. R. 3 E
9 miles SE of New Albany
 (distance) (direction) (nearest town)

WELL PURPOSE: None
 (home, irrigation, municipal, industrial)

WELL COMPLETION DATA:

(1) diameter (inches) 4"

(2) total depth (feet) 330'

(3) static water level (feet) 50' below above top of ground.

(4) casing metal, 80'
 (material) (depth)
4" if telescope see back.
 (size)

(5) screen None
 (length) (depth to top)
 (size) (material)

(6) pump 1 1/2 gal 7
 (HPV) (yield gpm)
Electric
 (type power)

(7) electric log no
 (yes or no)
 (organization running log)

(8) how well bottom plugged no

CODED


APR 20 1970

DRILLERS REMARKS:

MISS. BD. OF
WATER COM.

If well telescopes please sketch and show depths.

GROUND LEVEL

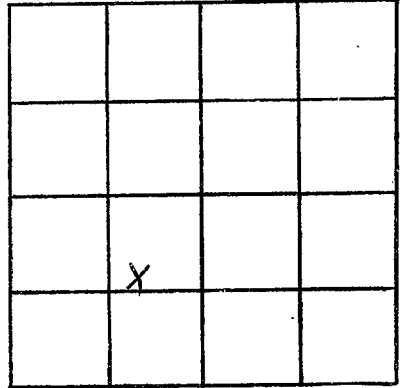

SECTION _____

Please indicate well location X.

ADDITIONAL INFORMATION

If more than one screen,
show locations of each on sketch.