

Union
M 16
4-15-70

MISSISSIPPI
BOARD OF WATER COMMISSIONERS
416 North State Street
Jackson, Mississippi 39201

CODED

WATER WELL DRILLERS LOG

4-15 19 70 J. T. Meekin Union
date well completed firm name county well located

LANDOWNER: Jim Cobb
New Albany
Miss
(mailing address)

description of formations encountered	from	to
Chert	0	16
Blue clay	16	27
Rock	27	36
Blue "	36	146
Rock	146	158
Sand	158	198
Blue "	198	250

WELL LOCATION:
sec. 5 T. 8 S. R. 3 E. 216
3 miles E of Ingersoll
(distance) (direction) (nearest town)

WELL PURPOSE:
(home, irrigation, municipal, industrial)

WELL COMPLETION DATA:

- (1) diameter (inches) 4
- (2) total depth (feet) 250
- (3) static water level (feet) 65 below top of ground
- (4) casing Black pipe 90 (material) (depth)
(size) If telescope see back.
- (5) screen (length) (depth to top)
(size) (material)
- (6) pump 1 (HP) 8 (yield gpm)
E (type power)
- (7) electric log (yes or no)
(organization running log)
- (8) how well bottom plugged open

CODED


MAY 5 1970

MISS. BD. OF
WATER COMMISSIONERS

DRILLERS REMARKS:

If well telescopes please sketch and show depths.

GROUND LEVEL

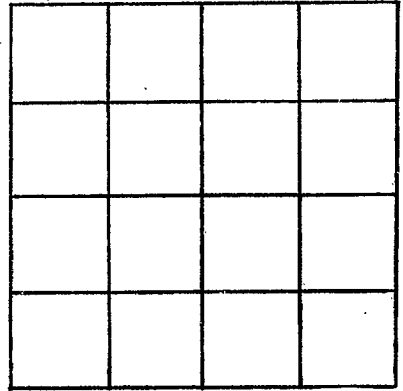

SECTION _____

Please indicate well location X.

ADDITIONAL INFORMATION

I drilled this well for Union Carb. Co. New Albany Miss.

If more than one screen, show locations of each on sketch.