

UNION
M 17
8-28-70

MISSISSIPPI
BOARD OF WATER COMMISSIONERS
416 North State Street
Jackson, Mississippi 39201

CODED

WATER WELL DRILLERS LOG

8-28 1970 (Clark Bros) Union
date well completed firm name county well located

LANDOWNER:

Frank Locker
St. one, New Albany
(mailing address)

description of formations encountered

from to

Red clay	0	20
Rock + sand	20	90
Blue mud	90	150
Rock + sand	150	208

WELL LOCATION:

sec. 5 T 8 N R 3 E 170
7 miles SE of New Albany
(distance) (direction) (nearest town)

WELL PURPOSE:

Home
(home, irrigation, municipal, industrial)

WELL COMPLETION DATA:

- (1) diameter (inches) 4"
- (2) total depth (feet) 200'
- (3) static water level (feet) 76' below top of ground.
- (4) casing metal, 84' (material) (depth)
4" (size) if telescope see back.
- (5) screen None (length) (depth to top)
- (6) pump 1/2 HP, 6 (HP) (yield gpm)
Electric (type power)
- (7) electric log no (yes or no)

(organization running log)

- (8) how well bottom plugged yes

DRILLERS REMARKS:


SEP 2 1970

MISS. BD. OF
WATER COMM.

CODED

If well telescopes please sketch and show depths.

GROUND LEVEL

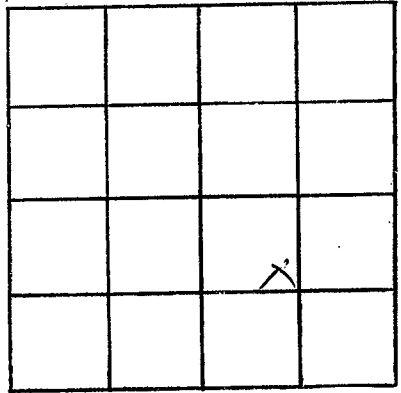

SECTION _____

Please indicate well location X.

ADDITIONAL INFORMATION

If more than one screen, show locations of each on sketch.