

UNION  
M 18  
2-27-71

MISSISSIPPI  
BOARD OF WATER COMMISSIONERS  
416 North State Street  
Jackson, Mississippi 39201

**CODED**

WATER WELL DRILLERS LOG

2-27-71 date well completed      1971 Clark Bros firm name      Union county well located

LANDOWNER:  
Food Mayo  
RT 2 New Albany  
(mailing address)

description of formations encountered	from	to
Red clay	0	14
Rock & Sand	14	34
Blue Mud	34	100
Rock & Sand	100	186

WELL LOCATION:  
sec. 2 T. 8 N. R. 3 E  
7 miles S of New Albany  
(distance) (direction) (nearest town)

WELL PURPOSE: None  
(home, irrigation, municipal, industrial)

- WELL COMPLETION DATA:
- (1) diameter (inches) 4"
  - (2) total depth (feet) 186'
  - (3) static water level (feet) 12' below above top of ground.
  - (4) casing metal, 42'  
(material) (depth)  
4" if telescope see back.  
(size)
  - (5) screen none  
(length) (depth to top)  
(size) (material)
  - (6) pump 1 gal 9  
(HP) (yield gpm)  
Electric  
(type power)
  - (7) electric log no  
(yes or no)  
(organization running log)
  - (8) how well bottom plugged no

**CODED**

MAR 15 1971

DRILLERS REMARKS:

MISS. BD. OF  
WATER COMMISSIONERS

If well telescopes please sketch and show depths.


GROUND LEVEL

Red clay

Rock + Sand

Blue mud

Rock + Sand

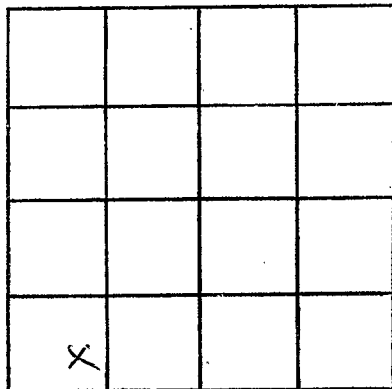

SECTION \_\_\_\_\_

Please indicate well location X.

ADDITIONAL INFORMATION

If more than one screen, show locations of each on sketch.