

UNION
M20
4-6-71

MISSISSIPPI
BOARD OF WATER COMMISSIONERS
416 North State Street
Jackson, Mississippi 39201

CODED

WATER WELL DRILLERS LOG

46 1971 J T Madlin UNION
date well completed firm name county well located

LANDOWNER: James
Mayo
Ingomar.
(mailing address)

description of formations encountered	from	to
Clay	0	13
yellow clay & Rock	13	27
Blue + Rock	27	106
Sand	106	138
Blue Clay	138	143
Rock sand	143	176
Blue Clay	176	180

WELL LOCATION:
sec. 7 T. 8 N. R. 3 E
1 miles E of Ingomar
(distance) (direction) (nearest town)

WELL PURPOSE:
(home, irrigation, municipal, industrial)

- WELL COMPLETION DATA:
- (1) diameter (inches) 4
 - (2) total depth (feet) 180
 - (3) static water level (feet) 38 below top of ground.
 - (4) casing P 62 (material) (depth) (size) If telescope see back.
 - (5) screen (length) (depth to top) (size) (material)
 - (6) pump 1/2 6 (HP) (yield gpm) E (type power)
 - (7) electric log. (yes or no) (organization running log)
 - (8) how well bottom plugged P N

CODED


MAY 4 - 1971

DRILLERS REMARKS:

MISS. BD. OF
WATER COMMISSIONERS

If well telescopes please sketch and show depths.

GROUND LEVEL

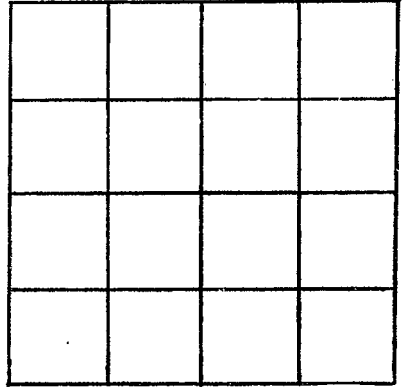

SECTION _____

Please indicate well location X.

ADDITIONAL INFORMATION

If more than one screen, show locations of each on sketch.