

**CODED**

M22  
7-4-60

**WATER WELL DRILLERS LOG**

M 305

Date: 7-4, 1960, Driller: G. F. Bartlett County Warren  
(Name)


(1) Owner of Land:	Description & Color of Materials Sand, Clay, Red Clay, Shell, etc.	Thick- ness Feet	Depth Feet
(Name) <u>JESSIE RYE</u> (Address) <u>NEW ALBANY MISS.</u>	<u>RED CLAY</u> <u>ROCK</u>		<u>20</u> <u>22</u>
(2) Location: <u>1/4, SW 1/4, Sec. 8 T 8 R 3</u> <u>7</u> miles <u>S.</u> of <u>N.A.</u> (distance) (direction) (Nearest Town)	<u>LIME ROCK</u> <u>WATER SAND</u> <u>SANDY ROCK</u>		<u>80</u> <u>100</u> <u>127</u>
(3) Topography: <u>FLAT</u> (Hilly) (Flat) (Level)			
(4) Purpose of Well: <u>DOMESTIC</u> (Domestic Irrigation Municipal, Industrial, Other)			

Information upon completion of well:

- (1) Diameter 4 inches.
- (2) Total Depth 127 feet.
- (3) Water Level 8 feet below top of ground.
- (4) Cased to 42, Size 4"
- (5) Screen: Size \_\_\_\_\_, Length \_\_\_\_\_
- (6) Were any formations sealed against pollution?  
 \_\_\_\_\_ yes, \_\_\_\_\_ no.

If YES depth of formation \_\_\_\_\_  
 Why \_\_\_\_\_

Drillers Remarks: \_\_\_\_\_

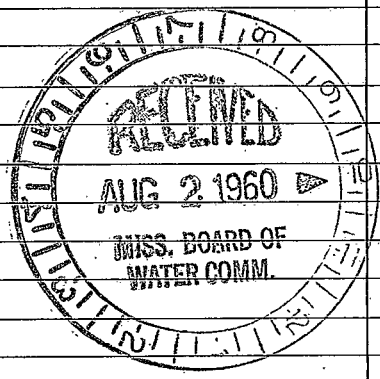

**CODED**

(Use Back Side)

Well No.  
M 305

CLAY LIME ROCK  
BLUE DIRT

150'

CASEING

20' REPCAY  
ROCK

ROCK  
12"

WATER  
SAND

SAND  
ROCK

100'

20'