

UNION MISSISSIPPI BOARD OF WATER COMMISSIONERS

M 23

1-23-62

WATER WELL DRILLERS LOG

CODED

Date: 1-23, 1962 Driller: B. F. Barfield County Monroe
(Name)

(1) Owner of Land: JESSIE RYE
(Name)
NEW ALBANY MISS
(Address)

(2) Location: 1/4 SW 1/4, Sec. 8, T. 8 R. 3,
7 miles S of NA
(distance) (direction) (Nearest Town)

(3) Topography: X
(Hilly) (Flat) (Level)

(4) Purpose of Well: D.O.M.
(Domestic Irrigation
Municipal, Industrial, Other)

Description & Color of Materials Sand, Clay, Red Clay, Shell, etc.	Thick- ness Feet	Depth Feet
<u>RED CLAY</u>	<u>20</u>	<u>20</u>
<u>ROCK</u>	<u>2</u>	<u>22</u>
<u>LIME ROCK</u>	<u>30</u>	<u>52</u>
<u>W - "</u>	<u>2</u>	<u>54</u>
<u>W SAND</u>	<u>30</u>	<u>84</u>

Information upon completion of well:

(1) Diameter 4 inches.

(2) Total Depth 84 feet.

(3) Water Level 1 m ~~feet~~ below top of ground.

(4) Cased to 4 0, Size _____

(5) Screen: Size _____, Length _____


(6) Were any formations sealed against pollution?
_____ yes, _____ no.

If YES depth of formation _____

Why _____

Drillers Remarks: _____

CODED

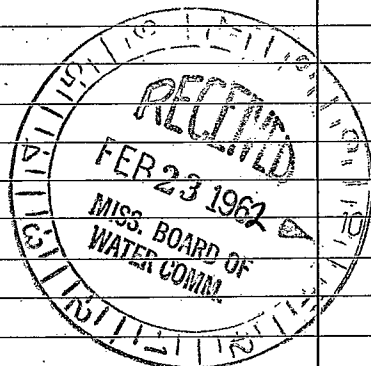

Well No. 23

(Use Back Side)

