

Union  
M26  
5-67

MISSISSIPPI  
BOARD OF WATER COMMISSIONERS  
416 North State Street  
Jackson, Mississippi 39201

**CODED**

WATER WELL DRILLERS LOG

5-9-67 19 LAMAR WILDER UNION  
date well completed firm name county well located

LANDOWNER:

C. R. SAPPINSTEIN

RT-1 - new albanys  
(mailing address)

description of formations encountered

from to

RED CLAY + SAND -	0	30
ROCK + SAND -	30	70
BLUE SHALES	70	600
FINE SAND (BLUE)	600	674
COARSE SAND (WHITE)	640	770

WELL LOCATION:


sec. 9 T. 30 S. R. 3 E #  
8 miles SE of NEW ALBANY  
(distance) (direction) (nearest town)

WELL PURPOSE: HOME  
(home, irrigation, municipal, industrial)

WELL COMPLETION DATA:

- (1) diameter (inches) 4
- (2) total depth (feet) 730
- (3) static water level (feet) 210 below top of ground.
- (4) casing STEEL (material), 240 (depth),  
4" (size) if telescope see back.
- (5) screen \_\_\_\_\_ (length) \_\_\_\_\_ (depth to top)  
(size) \_\_\_\_\_ (material)
- (6) pump 3/4 (HP), 4 (yield gpm)  
ELECT (type power)
- (7) electric log NO (yes or no)  
\_\_\_\_\_  
(organization running log)
- (8) how well bottom plugged \_\_\_\_\_


**CODED**

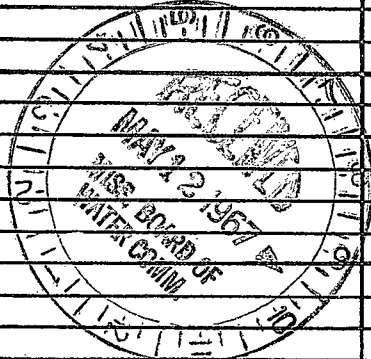

DRILLERS REMARKS:

If well telescopes please sketch and show depths.

GROUND LEVEL

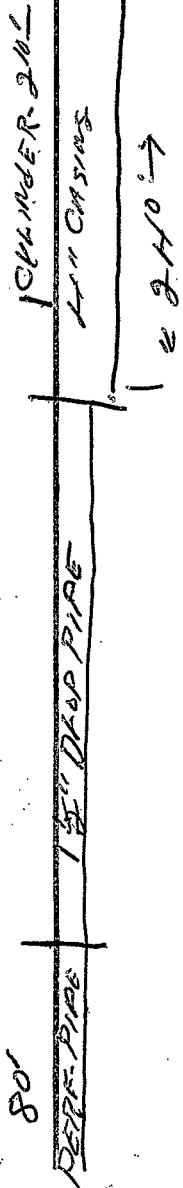

			●

SECTION 9

Please indicate well location X.

ADDITIONAL INFORMATION

If more than one screen, show locations of each on sketch.