

124

Union
M27
10-67

MISSISSIPPI
BOARD OF WATER COMMISSIONERS
416 North State Street
Jackson, Mississippi 39201

WATER WELL DRILLERS LOG

CODED

10-22
date well completed

1976 B. Z. Bartlett
firm name

Union
county well located

LANDOWNER:

HE KITCHENS
NEW ALBANY R. I.
(mailing/address)

description of formations
encountered

from to

RED DIRT	0	15'
ROCK	25	75'
BLUE DIRT	75	110'
WATER ROCK	110	114'
II SAND	114	150'

WELL LOCATION:

sec. 5 T. 8 S. R. 3 E.
6 miles SE of IVA
(distance) (direction) (nearest town)


WELL PURPOSE:

HOME
(home, irrigation, municipal, industrial)

WELL COMPLETION DATA:

- (1) diameter (inches) 4
- (2) total depth (feet) 150
- (3) static water level (feet) _____ below above top of ground.
- (4) casing STEEL 87
(material) (depth)
 if telescope see back.
(size)
- (5) screen _____
(length) (depth to top)
 (size) (material)
- (6) pump 3/4 6
(HP) (yield gpm)
E.L.F.
(type power)
- (7) electric log NU
(yes or no)
 (organization running log)
- (8) how well bottom plugged _____

CODED

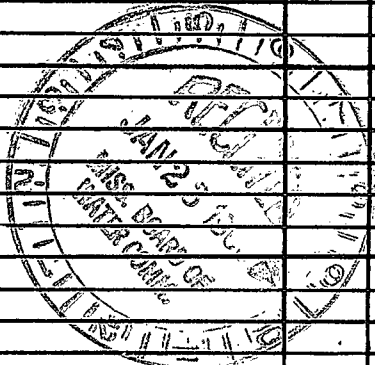

DRILLERS REMARKS:

If well telescopes please sketch and show depths.

GROUND LEVEL

		0	

SECTION _____

Please indicate well location X.

ADDITIONAL INFORMATION

If more than one screen, show locations of each on sketch.