

UNION
M 28
3-4-68

MISSISSIPPI
BOARD OF WATER COMMISSIONERS
416 North State Street
Jackson, Mississippi 39201

WATER WELL DRILLERS LOG **CODED**

March 4 1968 Clark Bros. date well completed firm name county well located

LANDOWNER:
Harland McTargoy
Rt 1, New Albany
(mailing address)


| description of formations encountered | from | to |
|---------------------------------------|------|-----|
| Red Clay | 0 | 20 |
| Rock + Gravel | 20 | 60 |
| Blue mud | 90 | 150 |
| Rocked Sand | 50 | 200 |

WELL LOCATION:
sec. 5 T. 8 N. R. 3 E
6 miles SE of New Albany
(distance) (direction) (nearest town)

WELL PURPOSE: home
(home, irrigation, municipal, industrial)

- WELL COMPLETION DATA:
- (1) diameter (inches) 4
 - (2) total depth (feet) 200
 - (3) static water level (feet) 70 below top of ground
 - (4) casing ^{Metals} ~~Steel~~ 72 (material) (depth)
 - 4 (size) if telescope see back.
 - (5) screen None (length) (depth to top)
 - (size) (material)
 - (6) pump 3/4 (HP) 8 (yield gpm)
 - Electric (type power)
 - (7) electric log No (yes or no)
 - (organization running log)
 - (8) how well bottom plugged No


CODED

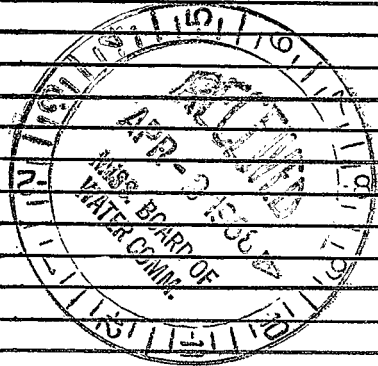

DRILLERS REMARKS:

If well telescopes please sketch and show depths.

GROUND LEVEL

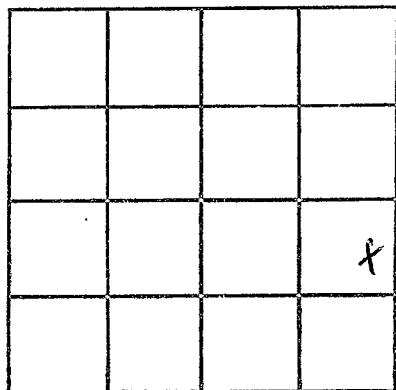

SECTION 5

Please indicate well location X.

ADDITIONAL INFORMATION

If more than one screen,
show locations of each on sketch.