

Union
 M 29
 9-24-68

MISSISSIPPI
 BOARD OF WATER COMMISSIONERS
 416 North State Street
 Jackson, Mississippi 39201

CODED

WATER WELL DRILLERS LOG

8-24# 1968 J.T. Medlin Union
 date well completed firm name county well located

LANDOWNER: J.O. Woods
 New Albany
 Mills
 (mailing address)

description of formations encountered	from	to
Red CLAY	0	18
ROCK + SAND	18	36
Blue CLAY	36	50
Red SAND	50	83
Blue CLAY	83	103
SAND, Red	103	135
ROCK, CLAY	135	163
BLACK SAND	163	193
Blue CLAY	193	200


WELL LOCATION:
 sec. 2 T. 7 N. R. 3 E
 3 miles S of Reagon
 (distance) (direction) (nearest town)

WELL PURPOSE: HOME
 (home, irrigation, municipal, industrial)

WELL COMPLETION DATA: 7-10-68

- (1) diameter (inches) 4"
- (2) total depth (feet) 200
- (3) static water level (feet) 135 below top of ground.
- (4) casing PLASTIC 200 (material) (depth)
 4 (size) if telescope see back.
- (5) screen 40 160 (length) (depth to top)
 4 PLASTIC (size) (material)
- (6) pump SP 10 (HP) (yield gpm)
 P/C (type power)
- (7) electric log (yes or no)
- (8) how well bottom plugged


CODED

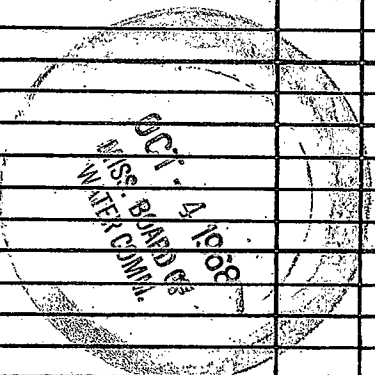

DRILLERS REMARKS:

If well telescopes please sketch and show depths.

GROUND LEVEL

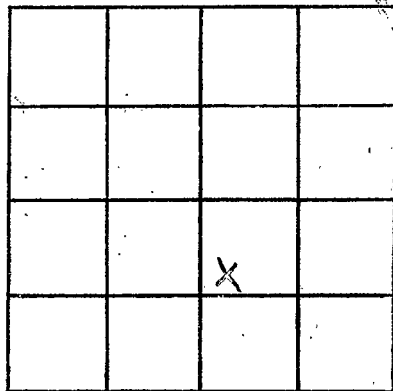

SECTION _____

Please indicate well location X.

ADDITIONAL INFORMATION

If more than one screen, show locations of each on sketch.