

UNION  
M 30  
4-13-72

MISSISSIPPI  
BOARD OF WATER COMMISSIONERS  
416 North State Street  
Jackson, Mississippi 39201

**CODED**

WATER WELL DRILLERS LOG

4/13 1972 Ed Clark Union  
date well completed firm name county well located

LANDOWNER:  
Bobby Payne  
RT Blue Springs  
(mailing address)

description of formations encountered	from	to
Sandy	0	30
Red Clay	30	70
Rock & Sand	70	180
Blue Mud	180	360
Rock & Sand	360	550

WELL LOCATION:  
sec. 5 T 8 N R. 3 E  
1 miles W of Blue Springs  
(distance) (direction) (nearest town)

WELL PURPOSE:  
(home, irrigation, municipal, industrial)

WELL COMPLETION DATA:

- (1) diameter (inches) 4"
- (2) total depth (feet) 550'
- (3) static water level (feet) 90' below top of ground.
- (4) casing Metal, 100'  
(material) (depth)  
4 (size) if telescope see back.
- (5) screen None  
(length) (depth to top)  
(size) (material)
- (6) pump 3/4 HP 4 (yield gpm)  
Electric (type power)
- (7) electric log No (yes or no)  
(organization running log)
- (8) how well bottom plugged No

**CODED**


APR 20 1972

MISS. Bd. of  
WATER COMMISSIONERS

DRILLERS REMARKS:

If well telescopes please sketch and show depths.

GROUND LEVEL

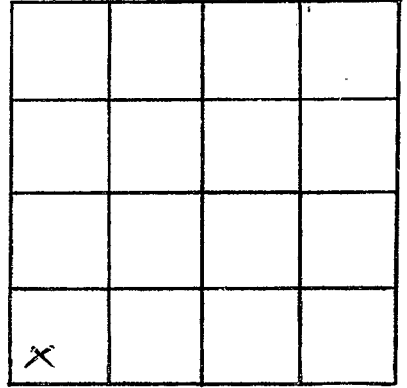

SECTION \_\_\_\_\_

Please indicate well location X.

ADDITIONAL INFORMATION

If more than one screen, show locations of each on sketch.