

UNION
M 32
6-23-74

MISSISSIPPI
BOARD OF WATER COMMISSIONERS
416 North State Street
Jackson, Mississippi 39201

CODED

WATER WELL DRILLERS LOG

June - 23 1974 date well completed Bobby L. Sowards firm name Union county well located

LANDOWNER: Joe Williams
New Albany, Miss (mailing address)

description of formations encountered	from	to
Red clay	0	25
Rock	25	40
Blue mud	40	60
Blue mud	60	90
Limestone	25	40
Rock	40	60
Blue Mud	60	90
Rock + Sand	90	190

WELL LOCATION:
sec. 7 T. 8 N. R. 3 E S. # 8
8 miles South of New Albany (distance) (direction) (nearest town)

WELL PURPOSE: Home (home, irrigation, municipal, industrial)

- WELL COMPLETION DATA:
- (1) diameter (inches) 4"
 - (2) total depth (feet) 190
 - (3) static water level (feet) 8 below top of ground.
 - (4) casing Steel, 83ft (material) (depth)
4" (size) if telescope see back.
 - (5) screen none (length) (depth to top)
(size) (material)
 - (6) pump none (HP) (yield gpm)
Electric none (type power)
 - (7) electric log (yes or no)
(organization running log)
 - (8) how well bottom plugged

CODED


DECEMBER 15 1974
JUL 26 1974

DRILLERS REMARKS:

MISS. BD. OF WATER COMMISSIONERS

If well telescopes please sketch and show depths.

GROUND LEVEL

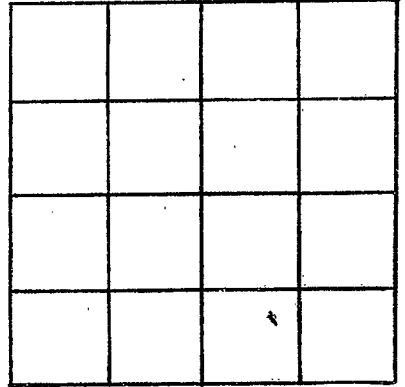

SECTION _____

Please indicate well location X.

ADDITIONAL INFORMATION

If more than one screen,
show locations of each on sketch.