

UNION
M 2000
4-24-78

**MISSISSIPPI  
BOARD OF WATER COMMISSIONERS**  
416 North State Street  
Jackson, Mississippi 39201

**WATER WELL DRILLERS LOG**

4-24-78      1978      Leeper      Union  
 date well completed      firm name      county well located

**LANDOWNER:**  
Norris Faulkner, Jr.  
R.F.D. New Albany  
 (mailing address)

description of fomations encountered	from	to
<u>Jointed clay</u>	<u>0</u>	<u>40</u>
<u>Soap stone</u>	<u>40</u>	<u>80</u>
<u>Clay</u>	<u>80</u>	<u>100</u>
<u>Sand</u>	<u>100</u>	<u>180</u>

**WELL LOCATION:**  
 sec. 18 T. 6 N. R. 3 E.  
1 miles N of Georgetown  
 (distance) (direction) (nearest town)

**WELL PURPOSE:** Home  
 (home, irrigation, municipal, industrial)

**WELL COMPLETION DATA:**

(1) diameter (inches) 4

(2) total depth (feet) 180'

(3) static water level (feet) 60 <sup>below</sup> above top of ground.

(4) casing steel, 84'  
 (material) (depth)

\_\_\_\_\_ if telescope see back.  
 (size)

(5) screen \_\_\_\_\_  
 (length) (depth to top)

\_\_\_\_\_ (size) \_\_\_\_\_ (material)

(6) pump 1/2 10  
 (HP) (yield gpm)

Elec  
 (type power)

(7) electric log no  
 (yes or no)

\_\_\_\_\_ (organization running log)


(8) how well bottom plugged open

**DRILLERS REMARKS:**

**RECEIVED**  
 MAY 5 - 1978  
 MISS. BD. OF WATER CONTROL

If well telescopes please sketch and show depths.

GROUND LEVEL

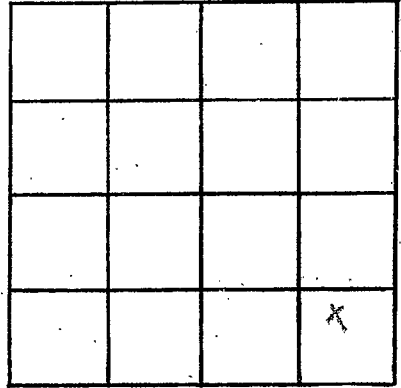

SECTION 18

Please indicate well location X.

ADDITIONAL INFORMATION

If more than one screen, show locations of each on sketch.