

UNION

M 2001

9-15-78

MISSISSIPPI BOARD OF WATER COMMISSIONERS 416 North State Street Jackson, Mississippi 39201

WATER WELL DRILLERS LOG

9-15 1978 Bobby Swords Polunio date well completed firm name county well located

LANDOWNER: Paul Denton

RT1

Ecorse, Miss (mailing address)

WELL LOCATION:

sec. 1 T. 8 N R. 3 E 8 miles South of New Albany (distance) (direction) (nearest town)

WELL PURPOSE: (home, irrigation, municipal, industrial)

WELL COMPLETION DATA:

- (1) diameter (inches) 4"
(2) total depth (feet) 150/180
(3) static water level (feet) 8 below top of ground.
(4) casing Steel, 8 3/4" (material) (depth) 4" (size) If telescope see back.
(5) screen None (length) (depth to top)
(6) pump 1/2 hp, 8 gpm (HP) (yield gpm) Electric (type power)
(7) electric log (yes or no)
(8) how well bottom plugged 0

Table with 3 columns: description of formations encountered, from, to. Rows include Red clay, Limestone, Rocks, Blue mud, Rock + Sand.

DRILLERS REMARKS:


RECEIVED stamp

OCT 23 1978

MISS. BD. OF WATER COMMISSIONERS

If well telescopes please sketch and show depths.

GROUND LEVEL

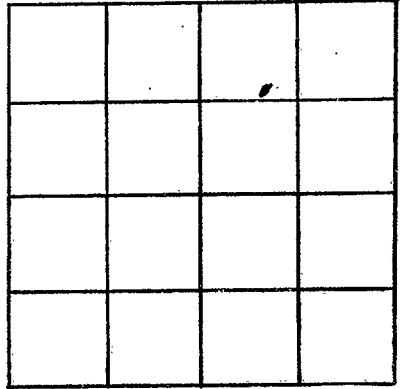

SECTION 7

Please indicate well location X.

ADDITIONAL INFORMATION

If more than one screen,
show locations of each on sketch.