

UNION

M 25002

9-24-78

MISSISSIPPI BOARD OF WATER COMMISSIONERS 416 North State Street Jackson, Mississippi 39201

WATER WELL DRILLERS LOG

9-24 1978 Bobby L Swords Union date well completed firm name county well located

LANDOWNER: ENOC H SWORDS

RTI ECRU

(mailing address)

WELL LOCATION:

sec. 7 T 8 N R 3 E 8 miles South of New Albany (distance) (direction) (nearest town)

WELL PURPOSE:

(home, irrigation, municipal, industrial)

WELL COMPLETION DATA:

(1) diameter (inches) 4" (2) total depth (feet) 185 (3) static water level (feet) 8 below top of ground.

(4) casing Steel 84 ft. (material) (depth) 4" if telescope see back. (size)

(5) screen none (length) (depth to top) (size) (material)


(6) pump 1 hp. 35t. 8 gpm (HP) (yield gpm) Electric (type power)

(7) electric log (yes or no) (organization running log)

(8) how well bottom plugged

DRILLERS REMARKS:


Table with 3 columns: Description of formations encountered, from, to. Rows include Red Clay, Rock, Blue mud, Rock, Sand.

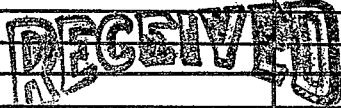

OCT 23 1978

If well telescopes please  
sketch and show depths.

GROUND LEVEL

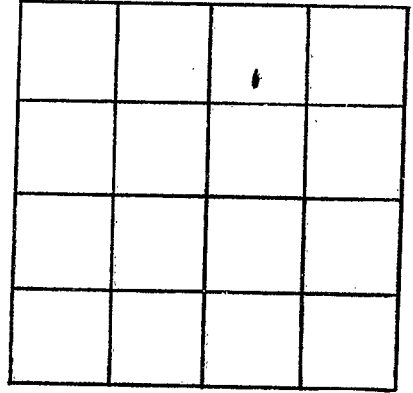

SECTION 7

Please indicate well location X.

ADDITIONAL INFORMATION

If more than one screen,  
show locations of each on sketch.