

UNION
M 2004
4-10-81

MISSISSIPPI
BOARD OF WATER COMMISSIONERS
416 North State Street
Jackson, Mississippi 39201

WATER WELL DRILLERS LOG

4-10-81 19 date well completed
S.F. Medlin firm name
Union county well located

LANDOWNER:
Randy Reeter
Hwy 15 S. New Albany
(mailing address)

description of formations encountered	from	to
SAND	0	40
CLAY & Rock	110	160
SAND & TWISTED	160	210

WELL LOCATION:
soc. 17 T 8 N R 3 E
3 miles (distance) of S (direction) of Sikee (nearest town)

WELL PURPOSE: (home irrigation, municipal, industrial)

WELL COMPLETION DATA:

- (1) diameter (inches) 4
- (2) total depth (feet) 210
- (3) static water level (feet) 20 below top of ground
- (4) casing PVC 190 (material) (depth)
- (size) If telescope see back.
- (5) screen 20" 190 (length) (depth to top)
- 4" PVC (size) (material)
- (6) pump 1/2 10 (HP) (yield gpm)
- Etc (type-power)
- (7) electric log (yes or no)

(organization running log)

(8) how well bottom plugged CAP


DRILLERS REMARKS:

DEPT. OF NATURAL RESOURCES
BUREAU OF LAND & WATER RESOURCES

MAY 29 1981
REC

If well telescopes please sketch and show depths.

GROUND LEVEL

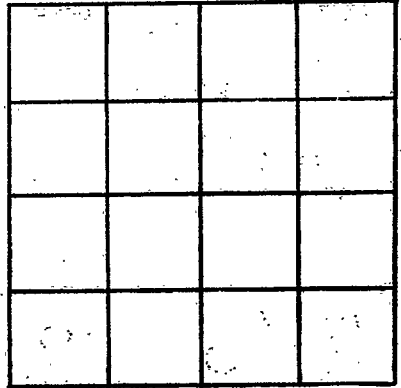

SECTION _____

Please indicate well location X.

ADDITIONAL INFORMATION

If more than one screen, show locations of each on sketch.