

UNION
 M 2005
 5-15-81

MISSISSIPPI
 BOARD OF WATER COMMISSIONERS
 416 North State Street
 Jackson, Mississippi 39201

WATER WELL DRILLERS LOG


5-15-81 19 J. T. Medlin Union
 date well completed firm name county well located

LANDOWNER: <u>Jimmy Thompson</u>	description of formations encountered	from	to
<u>Rt. 4</u>			
<u>Ecru, Ms. 38652</u> (mailing address)	<u>Red Clay</u>	<u>0</u>	<u>30</u>
	<u>Rock And Mixed Clay</u>	<u>30</u>	<u>100</u>
	<u>Sand And Rock</u>	<u>100</u>	<u>170</u>
WELL LOCATION: sec. <u>8</u> T. <u>7</u> N. R. <u>3</u> <u>W</u> <u>3</u> miles <u>E</u> of <u>INGOMAN</u> (distance) (direction) (nearest town)			
WELL PURPOSE: <input checked="" type="checkbox"/> home irrigation, municipal, industrial			
WELL COMPLETION DATA:			
(1) diameter (inches) <u>4</u>			
(2) total depth (feet) <u>170</u>			
(3) static water level (feet) <u>60</u> <u>below</u> top of ground.			
(4) casing <u>PVC</u> <u>150</u> (material) (depth)			
(size) If telescope see back.			
(5) screen _____ (length) _____ (depth to top)			
(size) _____ (material) _____			
(6) pump <u>1/2</u> <u>10</u> (HP) (yield gpm)			
<u>Elec.</u> (type power)			
(7) electric log _____ (yes or no)			
(organization running log)			
(8) how well bottom plugged <u>cap</u>			
DRILLERS REMARKS:			

DEPT. OF NATURAL RESOURCES
 BUREAU OF LAND & WATER RESOURCES
 MAY 20 1981

If well telescopes please sketch and show depths.

GROUND LEVEL

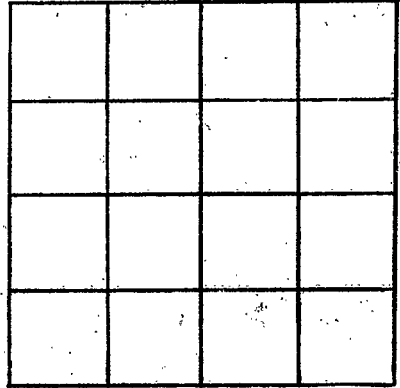

SECTION _____

Please indicate well location X.

ADDITIONAL INFORMATION

If more than one screen, show locations of each on sketch.