

MISSISSIPPI  
 BOARD OF WATER COMMISSIONERS  
 416 North State Street  
 Jackson, Mississippi 39201  
 MS-GW-00852  
 WATER WELL DRILLERS LOG

**COBLEN** #17

Union Co  
 N 12  
 1-24-70

1-24 1970 Herndon-Homan Well Union  
 date well completed firm name #Supply county well located


LANDOWNER	description of formations encountered	from	to
Blue Springs Water Assoc.	Red Sand	0	10
Blue Springs Miss (mailing/address)	Mumbo Sand	10	30
	Sand	30	35
WELL LOCATION:	Mumbo Sand	35	40
sec. 10 T-8 R-4	White Sand	40	50
Blue Springs	Blue Rock	50	230
of Blue Springs	White Chalk	230	420
(distance) miles (direction) (nearest town)	Coffee Sand	420	440
WELL PURPOSE: municipal	Shale Rock	440	445
(home, irrigation, municipal, industrial)	Coffee Sand	445	450
WELL COMPLETION DATA:	Rock	450	454
(1) diameter (inches) 8 x 4	Coffee Sand	454	480
(2) total depth (feet) 512	Rock	480	483
(3) static water level (feet) 187 below top of ground	Coffee Sand	483	520
(4) casing Steel 420' (material) (depth)	Mumbo Sand	520	550
8" if telescope see back. (size)	Mumbo Sand	550	560
(5) screen 47' 11" 363' Lap (length) (depth to top)	Mumbo Sand	560	570
4" Stainless Steel (size) (material)	Mumbo Sand	570	580
(6) pump 25 130 (HP) (yield gpm)	Mumbo Sand	580	590
Electric (type power)	Mumbo Sand	590	600
(7) electric log yes (yes or no)	Mumbo Sand	600	616
UBS (organization running log)			
(8) how well bottom plugged Rock Wash			
DRILLERS REMARKS:			

JUN 15 1970

MISS. Bd. of WATER COMMISSIONERS

(7)

If well telescopes please sketch and show depths.

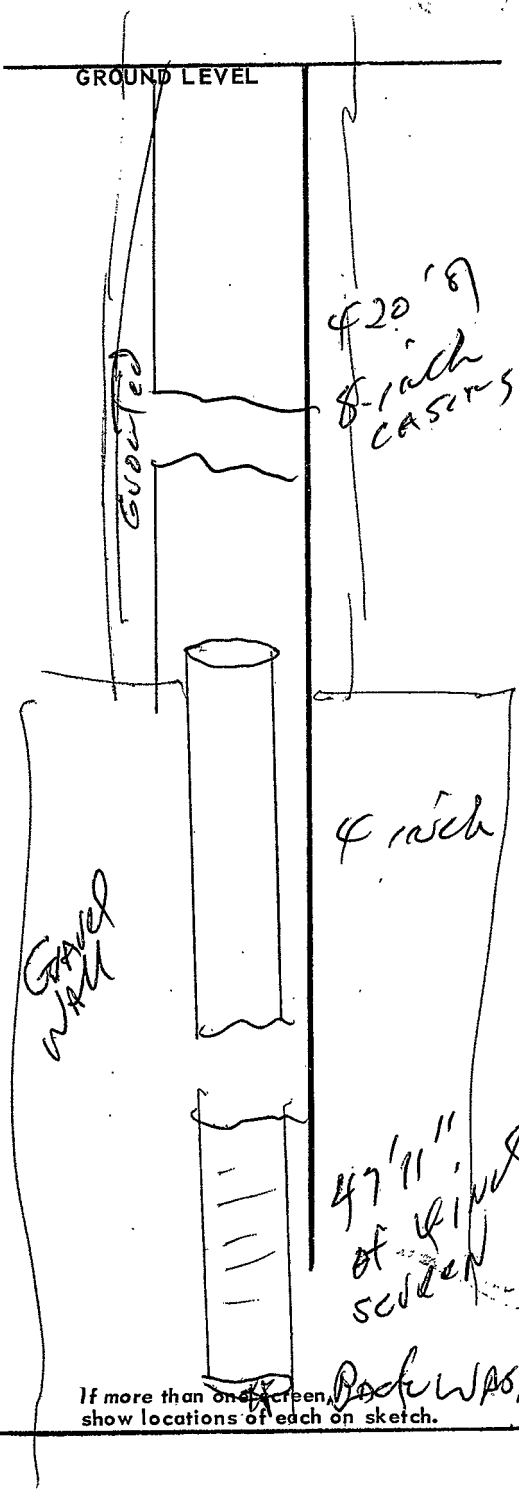


SECTION 10

Please indicate well location X.

ADDITIONAL INFORMATION

Bottom of Ssced 572'

Screen From Bottom up

10' 10" of ssced

21' 10" Blank

10' 0" of Ssced

21' 1" Blank

26' 2" Ssced

63' 34" of 4" LAP.

363' To Top of LAP

If more than one screen, show locations of each on sketch.

47 1/2" of 4 inch screen

Rock Wash