

CODED
CODED

MISSISSIPPI
BOARD OF WATER COMMISSIONERS
416 North State Street
Jackson, Mississippi 39201

WATER WELL DRILLERS LOG

CODED

Union
N 13.
8-69

Aug 19 1969 date well completed
J. W. Wilk & Sons firm name
Union county well located

LANDOWNER: <u>Martin Miller</u>	description of formations encountered	from	to
<u>Blue Springs</u> (mailing address)	Soil	0	12
	Sand + Clay	12	80
	Blue Rock	80	180
	Water Sand	180	320
WELL LOCATION: sec. <u>7</u> T <u>8</u> S N R <u>14</u> E S W			
<u>1/2</u> miles <u>East</u> of <u>New Albany</u> (distance) (direction) (nearest town)			
WELL PURPOSE: (home, irrigation, municipal, industrial)			
WELL COMPLETION DATA:			
(1) diameter (inches) <u>5</u>			
(2) total depth (feet) <u>320</u>			
(3) static water level (feet) <u>160</u> below above top of ground.			
(4) casing <u>Steel</u> , <u>86</u> , (material) (depth)			
<u>5</u> (size) if telescope see back.			
(5) screen _____, (length) (depth to top)			
(size) (material)			
(6) pump <u>1/2 HP</u> <u>6</u> (HP) (yield gpm)			
<u>Elec</u> (type power)			
(7) electric log _____ (yes or no)			
_____ (organization running log)			
(8) how well bottom plugged _____			


CODED

SEP 2 1969
MISS. DIV. OF
WATER CONTROL

DRILLERS REMARKS:

If well telescopes please sketch and show depths.

GROUND LEVEL

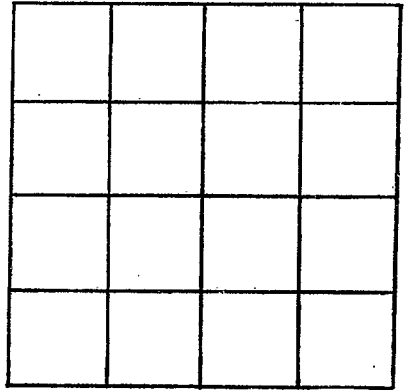

SECTION 2

Please indicate well location X.

ADDITIONAL INFORMATION

If more than one screen,
show locations of each on sketch.