

CODED

MISSISSIPPI
BOARD OF WATER COMMISSIONERS
416 North State Street
Jackson, Mississippi 39201

WATER WELL DRILLERS LOG

CODED

Union
N 14
9-25-69

Sept 25 1969 J. W. Webb & Son Union
date well completed firm name county well located

LANDOWNER: Robert Daniels

description of formations encountered

from to

Blue Springs
(mailing address)

soil 0 9
clunko 9 36
Blue Rock 36 250
Water Sand 250 340
Coffee

WELL LOCATION:

sec. 8 T. 13 N. R. 5 E
3 miles north of Sherman
(distance) (direction) (nearest town)

WELL PURPOSE:
(home, irrigation, municipal, industrial)

WELL COMPLETION DATA:

- (1) diameter (inches) 5
- (2) total depth (feet) 340
- (3) static water level (feet) 149 below top of ground.
- (4) casing Steel 4.011
(material) (depth)
5" If telescope see back.
(size)
- (5) screen _____
(length) (depth to top)
(size) (material)
- (6) pump 1/2 Harsco 60
(HP) (yield gpm)
Elec
(type power)
- (7) electric log _____
(yes or no)
(organization running log)
- (8) how well bottom plugged _____

CODED


REC - 8 1969

DRILLERS REMARKS:

MISS. BD. OF
WATER COMM.

If well telescopes please sketch and show depths.

GROUND LEVEL

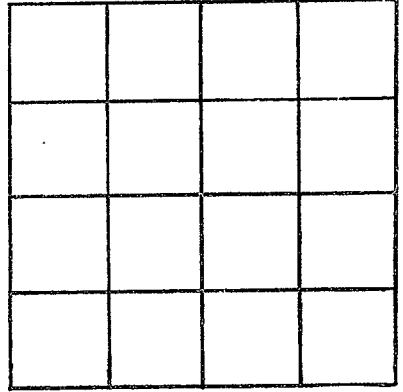

SECTION _____

Please indicate well location X.

ADDITIONAL INFORMATION

If more than one screen, show locations of each on sketch.