

Union
N 16
5-9-70

MISSISSIPPI
BOARD OF WATER COMMISSIONERS
416 North State Street
Jackson, Mississippi 39201

CODED

WATER WELL DRILLERS LOG

5-9-1970 date well completed
J T Modlin firm name
Union county well located

LANDOWNER: Robert Rokestraw

description of formations encountered

from to

New Albany Miss (mailing address) 216

Clay	0	18
SAND	18	29
Blue Clay	29	56
SAND	56	72
B.C. Clay	72	480
PACK SAND	480	486
SAND	486	533

WELL LOCATION:

sec. 3 T. 8 N. R. 4 E
2 1/2 miles E of Blue Springs
(distance) (direction) (nearest town)

WELL PURPOSE:
(home, irrigation, municipal, industrial)

WELL COMPLETION DATA:

- (1) diameter (inches) 4
- (2) total depth (feet) 533
- (3) static water level (feet) 180 below top of ground.
- (4) casing P 115
(material) (depth)
4 If telescope see back.
(size)
- (5) screen _____
(length) (depth to top)
(size) (material)
- (6) pump 3/4 8
(HP) (yield gpm)
E
(type power)
- (7) electric log _____
(yes or no)
(organization running log)
- (8) how well bottom plugged _____

CODED


JUN 9 1970

DRILLERS REMARKS:

MISS. BD. OF
WATER COM.

If well telescopes please sketch and show depths.

GROUND LEVEL

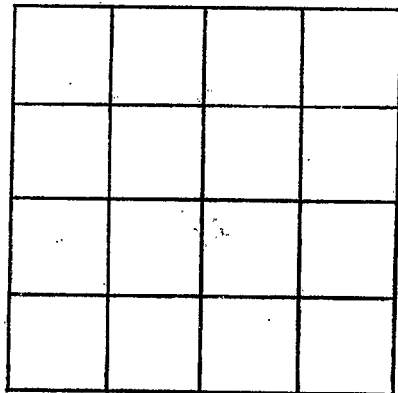

SECTION _____

Please indicate well location X.

ADDITIONAL INFORMATION

If more than one screen, show locations of each on sketch.