

Union  
N 17  
6-15-70

MISSISSIPPI  
BOARD OF WATER COMMISSIONERS  
416 North State Street  
Jackson, Mississippi 39201

**CODED**

WATER WELL DRILLERS LOG

6-15 1970 Ed Clark Union  
date well completed firm name county well located

LANDOWNER:  
Ralph Harris  
Blue Springs  
(mailing address)

description of formations encountered	from	to
Sand & Rock	0	30
Blue mar	30	210
Rock & Sand	210	300
Blue mud	310	390
Rock & Sand	390	572

WELL LOCATION:  
sec. 12 T 8 R 4 E  
12 miles S E of New Albany  
(distance) (direction) (nearest town)

WELL PURPOSE: Home  
(home, irrigation, municipal, industrial)

WELL COMPLETION DATA:

(1) diameter (inches) 4"  
(2) total depth (feet) 572'  
(3) static water level (feet) 100' below top of ground.  
(4) casing metal 84' (material) (depth)  
4" (size) if telescope see back.  
(5) screen none (length) (depth to top)  
(6) pump Rod 5 (HP) (yield gpm)  
Electric (type power)  
(7) electric log no (yes or no)  
(organization running log)  
(8) how well bottom plugged no


**CODED**

JUL 1 1970

DRILLERS REMARKS:

If well telescopes please sketch and show depths.

GROUND LEVEL

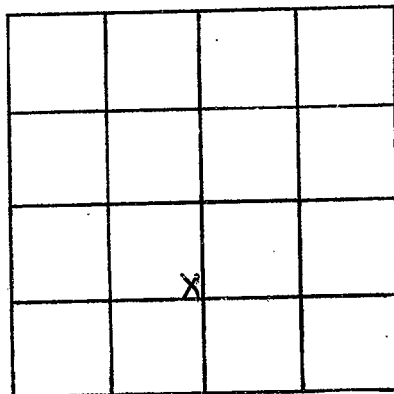

SECTION \_\_\_\_\_

Please indicate well location X.

ADDITIONAL INFORMATION

If more than one screen, show locations of each on sketch.