

MISSISSIPPI
BOARD OF WATER COMMISSIONERS
416 North State Street
Jackson, Mississippi 39201

CODED

WATER WELL DRILLERS LOG

UNION
N18
10-12-70

Oct 12 1970 J. W. Webb & Sons Union
date well completed firm name county well located

LANDOWNER: <u>B. N. Dyer</u>	description of formations encountered	from	to
	<u>Soil</u>	<u>0</u>	<u>21</u>
<u>Blue Springs Miss</u> (mailing address)	<u>Sand & Rock</u>	<u>2</u>	<u>65</u>
	<u>Sand & Blue Clay</u>	<u>65</u>	<u>195</u>
	<u>Blue Rock</u>	<u>195</u>	<u>515</u>
WELL LOCATION: sec. <u>5</u> T. <u>8S</u> N. R. <u>4</u> <u>W</u>	<u>Water Rock</u>	<u>515</u>	<u>516</u>
<u>1 1/2</u> miles <u>North</u> of <u>Blue Springs</u> (distance) (direction) (nearest town)	<u>Water sand</u>	<u>516</u>	<u>690</u>
	<u>Coffee sand</u>		
WELL PURPOSE: (home, irrigation, municipal, industrial)			
WELL COMPLETION DATA:			
(1) diameter (inches) <u>4"</u>			
(2) total depth (feet) <u>640</u>			
(3) static water level (feet) <u>201</u> below above top of ground.			
(4) casing <u>Steel</u> , <u>204ft</u> (material) (depth)			
<u>4"</u> (size) if telescope see back.			
(5) screen <u>0</u> , <u>0</u> (length) (depth to top)			
<u>0</u> , <u>0</u> (size) (material)			
(6) pump <u>3/4 sub</u> , <u>9</u> (HP) (yield gpm)			
<u>Elec</u> (type power)			
(7) electric log <u>0</u> (yes or no)			
<u>0</u> (organization running log)			
(8) how well bottom plugged <u>Open</u>			
DRILLERS REMARKS:			


CODED

NOV 16 1970

MISS. BD. OF
WATER COMM.

If well telescopes please sketch and show depths.

GROUND LEVEL

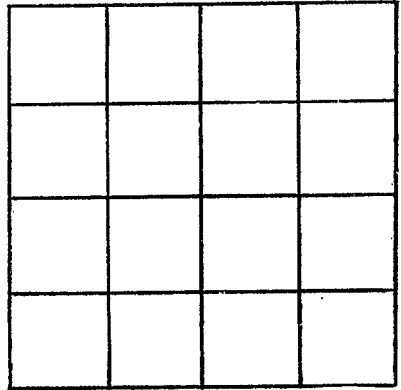

SECTION _____

Please indicate well location X.

ADDITIONAL INFORMATION

If more than one screen, show locations of each on sketch.