

UNION
 N19
 11-13-70

MISSISSIPPI
 BOARD OF WATER COMMISSIONERS
 416 North State Street
 Jackson, Mississippi 39201

CODED

WATER WELL DRILLERS LOG

UNION
[Signature]

11-13
 date well completed

1970 Herndon-Homan Well & Supply
 firm name

county well located

LANDOWNER: Wayne Bullock
545 Walnut St.
Jupelo, Miss.
 (mailing address)

description of formations encountered

from to

surface sand & clay	0	28
Blue clay	28	160
Sand with	160	300
	300	

WELL LOCATION:

sec. 6 T. 8 N. R. 5 E.
 S. W.
3 1/4 miles NE of Blue Springs
 (distance) (direction) (nearest town)

WELL PURPOSE: Home
 (home, irrigation, municipal, industrial)

WELL COMPLETION DATA:

- (1) diameter (inches) 4"
- (2) total depth (feet) 300'
- (3) static water level (feet) 62 below above top of ground.
- (4) casing Steel, 33' (material), (depth)
4" (size) if telescope see back.
- (5) screen NO (length), (depth to top)
 (size), (material)
- (6) pump NO (HP), (yield gpm)
 (type power)
- (7) electric log NO (yes or no)
 (organization running log)
- (8) how well bottom plugged Open

CODED


DEC 1 2 1970

DRILLERS REMARKS:

MISS. BD. OF
 WATER COMM

If well telescopes please sketch and show depths.

GROUND LEVEL

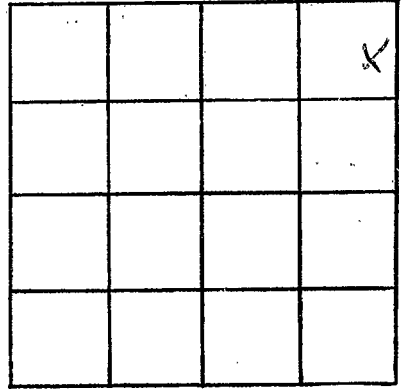

SECTION 6

Please indicate well location X.

ADDITIONAL INFORMATION

If more than one screen,
show locations of each on sketch.