

MISSISSIPPI  
BOARD OF WATER COMMISSIONERS  
416 North State Street  
Jackson, Mississippi 39201

CODED  
CODED

WATER WELL DRILLERS LOG

Union  
N 21  
7-3-69

July 3 1969 J. W. Wellborn Union  
date well completed firm name county well located

LANDOWNER: Troy Leach  
Blue Springs, Miss

description of formations encountered	from	to
Clay	0	12
Blue marl	12	380
Sand	380	490
Blue marl	490	500

(mailing address)

WELL LOCATION:

sec. 10 T 45 N R 4 E  
S S W  
1/2 miles S of Blue Springs  
(distance) (direction) (nearest town)

WELL PURPOSE: home  
(home, irrigation, municipal, industrial)

WELL COMPLETION DATA:

- (1) diameter (inches) 5"
- (2) total depth (feet) 500'
- (3) static water level (feet) 160 below top of ground.
- (4) casing steel 21'  
(material) (depth)

(size) if telescope see back.

- (5) screen none  
(length) (depth to top)

(size) (material)

- (6) pump 1/2 10  
(HP) (yield gpm)

electric  
(type power)

- (7) electric log no  
(yes or no)

(organization running log)

- (8) how well bottom plugged

CODED


FORM 6 - 1964

DRILLERS REMARKS:

MISS. BD. OF  
WATER COMMISSIONERS

If well telescopes please sketch and show depths.

GROUND LEVEL

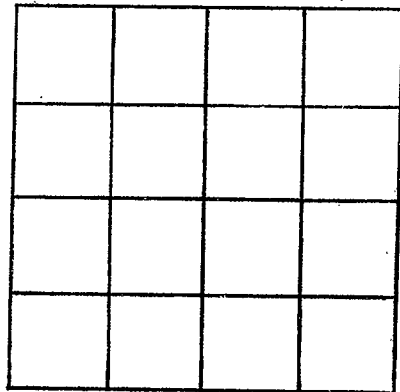

SECTION 10

Please indicate well location X.

ADDITIONAL INFORMATION

If more than one screen,  
show locations of each on sketch.