

UNION
N 22
4-15-71

MISSISSIPPI
BOARD OF WATER COMMISSIONERS
416 North State Street
Jackson, Mississippi 39201

CODED

WATER WELL DRILLERS LOG

Herndon-Homan Well & Supply, Inc.

P. O. Box 42

Union

4-15 19 71
date well completed

SEAFORD, MISSISSIPPI 38868 county well located

LANDOWNER: *Mrs. Patricia Billingsley*
Route 3
Blue Springs, Miss.
(mailing address)

description of formations encountered	from	to
<i>Surface sand & clay</i>	<i>0</i>	<i>32</i>
<i>Blue clay</i>	<i>32</i>	<i>160</i>
<i>Sand</i>	<i>160</i>	<i>300</i>
<i>Bitum.</i>	<i>300</i>	

WELL LOCATION:
sec. 6 T. 8 N. R. 5 E
S W
2 1/2 miles E of Blue Springs
(distance) (direction) (nearest town)

WELL PURPOSE: *home*
(home, irrigation, municipal, industrial)

- WELL COMPLETION DATA:
- diameter (inches) 5"
 - total depth (feet) 300'
 - static water level (feet) 56' below above top of ground.
 - casing Steel 36' 2"
(material) (depth)
5" if telescope see back.
(size)
 - screen 70
(length) (depth to top)
(size) (material)
 - pump 1/2 5
(HP) (yield gpm)
Electric
(type power)
 - electric log no
(yes or no)
(organization running log)
 - how well bottom plugged open

CODED			


MAY 18 1971

DRILLERS REMARKS:

MISS. BD. OF
WATER COMMISSIONERS
JACKSON, MISSISSIPPI

If well telescopes please sketch and show depths.

GROUND LEVEL

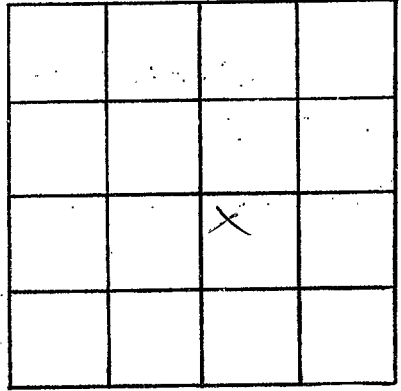

SECTION 6

Please indicate well location X.

ADDITIONAL INFORMATION

If more than one screen, show locations of each on sketch.