

UNION
N-24
7-13-71

MISSISSIPPI
BOARD OF WATER COMMISSIONERS
416 North State Street
Jackson, Mississippi 39201

CODED

WATER WELL DRILLERS LOG

Bernard-Horman Well & Supply, Inc.

P. O. Box 42

Union

7-13 1971
date well completed

~~MISSISSIPPI~~

firm name

county well located

LANDOWNER: Tony Henry
Route 3
Blue Springs, Miss
(mailing address)

description of formations encountered	from	to
<u>Surface sand & clay</u>	<u>0</u>	<u>18</u>
<u>Blue clay</u>	<u>18</u>	<u>160</u>
<u>Sand</u>	<u>160</u>	<u>300</u>
<u>Bottom</u>	<u>300</u>	

WELL LOCATION:
sec. 5 T 8 N R. 5 E
S W
2 1/2 miles SE of Fairfield
(distance) (direction) (nearest town)

WELL PURPOSE: Home
(home, irrigation, municipal, industrial)

- WELL COMPLETION DATA:
- (1) diameter (inches) 5"
 - (2) total depth (feet) 300'
 - (3) static water level (feet) 50 below top of ground.
 - (4) casing Steel, 20' 10"
(material) (depth)
5" if telescope see back.
(size)
 - (5) screen NO
(length) (depth to top)
(size) (material)
 - (6) pump 1/2 5
(HP) (yield gpm)
electric
(type power)
 - (7) electric log no
(yes or no)
(organization running log)
 - (8) how well bottom plugged open

DRILLERS REMARKS:


CODED

AUG 4 - 1971

MISS. Bd. OF

If well telescopes please sketch and show depths.

GROUND LEVEL

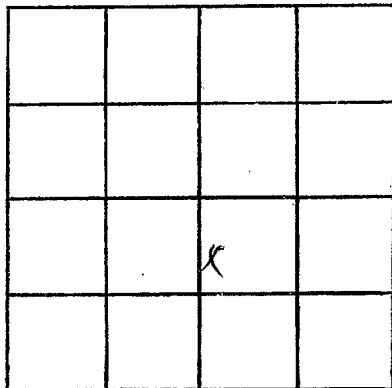

SECTION 5

Please indicate well location X.

ADDITIONAL INFORMATION

If more than one screen, show locations of each on sketch.