

CODED

Union
N-25
B-19-71

MISSISSIPPI
BOARD OF WATER COMMISSIONERS
416 North State Street
Jackson, Mississippi 39201

WATER WELL DRILLERS LOG

Horton-Homan Well & Supply, Inc.

P. O. Box 42

Union

8-19 1971
date well completed

SHANNON MISSISSIPPI 38802 county well located

LANDOWNER: <u>Sammy Bonds</u>	description of formations encountered	from	to
<u>Route 3</u>	<u>Surface mud & clay</u>	<u>0</u>	<u>18</u>
<u>Blue Springs, Miss.</u>	<u>Blue clay</u>	<u>18</u>	<u>180</u>
(mailing address)	<u>Sand</u>	<u>180</u>	<u>300</u>
WELL LOCATION:	<u>B576</u>	<u>300</u>	
sec. <u>6</u> T. <u>8</u> R. <u>5</u>			
<u>2</u> miles <u>E</u> of <u>Fairfield</u>			
WELL PURPOSE: <u>home</u>			
(home, irrigation, municipal, industrial)			
WELL COMPLETION DATA:			
(1) diameter (inches) <u>5"</u>			
(2) total depth (feet) <u>300'</u>			
(3) static water level (feet) <u>50</u> below top of ground.			
(4) casing <u>Steel</u> , <u>21'</u>			
(material) (depth)			
<u>5"</u> if telescope see back.			
(size)			
(5) screen <u>no</u>			
(length) (depth to top)			
(size) (material)			
(6) pump <u>1/2</u> <u>5</u>			
(HP) (yield gpm)			
<u>electric</u>			
(type power)			
(7) electric log <u>no</u>			
(yes or no)			
(organization running log)			
(8) how well bottom plugged <u>open</u>			

CODED


SEP 7 1971

MISS. BD. OF WATER COMMISSIONERS

DRILLERS REMARKS:

If well telescopes please sketch and show depths.

GROUND LEVEL

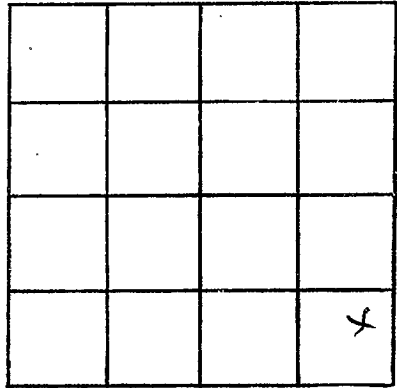

SECTION 6

Please indicate well location X.

ADDITIONAL INFORMATION

If more than one screen, show locations of each on sketch.