

Union
N-26
8-2-71

MISSISSIPPI
BOARD OF WATER COMMISSIONERS
416 North State Street
Jackson, Mississippi 39201

CODED

WATER WELL DRILLERS LOG

Aug 2 1971 J. W. Webb & Sons Union
date well completed firm name county well located

LANDOWNER: <u>Wade Lambell</u>	description of formations encountered	from	to
<u>Blue Springs miss</u> (mailing address)	<u>Soil</u>	0	1
	<u>pipe clay</u>	1	31
	<u>Blue Rock</u>	31	279
	<u>Water Rock</u>	279	281
	<u>Water sand</u>	281	408
	<u>Coffee sand</u>		
WELL LOCATION: sec. <u>13</u> T. <u>85</u> N R. <u>4</u> E S			
<u>2 1/2</u> miles <u>N</u> east of <u>Sherman</u> (distance) (direction) (nearest town)			
WELL PURPOSE: (home, irrigation, municipal, industrial)			
WELL COMPLETION DATA:			
(1) diameter (inches) <u>5</u>			
(2) total depth (feet) <u>400</u>			
(3) static water level (feet) <u>171</u> below top of ground.			
(4) casing <u>Steel</u> , <u>44'</u> (material) (depth)			
<u>5"</u> (size) if telescope see back.			
(5) screen <u>0</u> , <u>0</u> (length) (depth to top)			
<u>0</u> , <u>0</u> (size) (material)			
(6) pump <u>Eveready</u> <u>3</u> (HP) (yield gpm)			
<u>Electric</u> (type power)			
(7) electric log <u>no</u> (yes or no)			
(organization running log)			
(8) how well bottom plugged			
DRILLERS REMARKS:			


CODED

SEP 16 1971

MISS. BD. OF
WATER COMM.

If well telescopes please sketch and show depths.

GROUND LEVEL

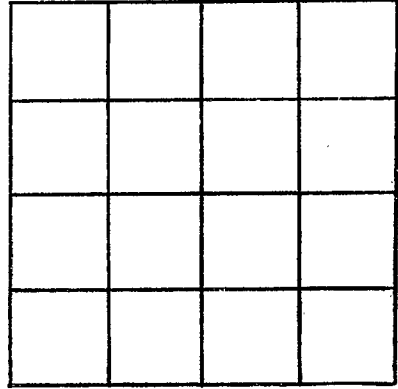

SECTION _____

Please indicate well location X.

ADDITIONAL INFORMATION

If more than one screen,
show locations of each on sketch.