

Union
N 27
9-20-71

MISSISSIPPI
BOARD OF WATER COMMISSIONERS
416 North State Street
Jackson, Mississippi 39201

CODED

WATER WELL DRILLERS LOG

Merrison-Homan Well & Supply, Inc.

P. O. Box 42

Union

9-20

1971

date well completed

Union, Mississippi

county well located

LANDOWNER: Mrs. Ruth McCoy
Sherman, Miss.

description of formations encountered	from	to
Surface mud + clay	0	33
Blue clay	33	200
Sand	200	360
Bottom	360	

(mailing address)

WELL LOCATION:

sec. 13 T. 8 N. R. 4 E
2 miles N of Sherman
(distance) (direction) (nearest town)

WELL PURPOSE: home
(home, irrigation, municipal, industrial)

WELL COMPLETION DATA:

- (1) diameter (inches) 5"
- (2) total depth (feet) 360'
- (3) static water level (feet) 132 below top of ground.
- (4) casing Steel 36'10"
(material) (depth)
5" if telescope see back.
(size)
- (5) screen 70 (length) (depth to top)
(size) (material)
- (6) pump 1/2 (HP) 5 (yield gpm)
Electric (type power)
- (7) electric log no (yes or no)
(organization running log)
- (8) how well bottom plugged open

CODED


OCT 12 1971

DRILLERS REMARKS:

MISS. RD. OF
WATER COMM.

If well telescopes please sketch and show depths.

GROUND LEVEL

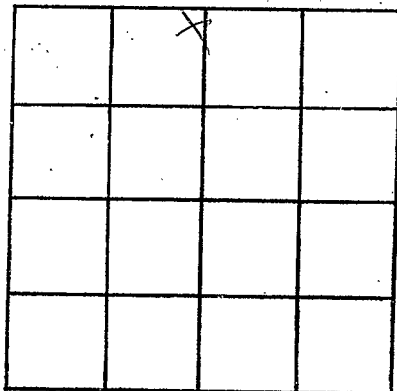

SECTION 13

Please indicate well location X.

ADDITIONAL INFORMATION

If more than one screen, show locations of each on sketch.