

120

Union  
N31  
4-67

MISSISSIPPI  
BOARD OF WATER COMMISSIONERS  
416 North State Street  
Jackson, Mississippi 39201

WATER WELL DRILLERS LOG

**CODED**

4-21-1967 CFC CARLISLE UNION  
date well completed firm name county well located

LANDOWNER:

E L KOLB  
BLUESPRINGS RFD  
(mailing address)

description of formations encountered

from to

RED CLAY-SAND 0 47  
ROCK 47 83  
BLUE DIRT 83 130  
ROCK 130 160  
W SAND 160 200

WELL LOCATION:


sec 18 T 8 N R 2 E X  
10 miles SE of NA  
(distance) (direction) (nearest town)

WELL PURPOSE: HOME  
(home, irrigation, municipal, industrial)

WELL COMPLETION DATA:

- (1) diameter (inches) 4"
- (2) total depth (feet) 200
- (3) static water level (feet) 50 below top of ground.
- (4) casing STEEL 105  
(material) (depth)
- (5) screen (size) (length) (depth to top)
- (6) pump 1 (HP) 3 (yield gpm)  
ELECTRIC (type power)
- (7) electric log NO (yes or no)
- (8) how well bottom plugged

**CODED**

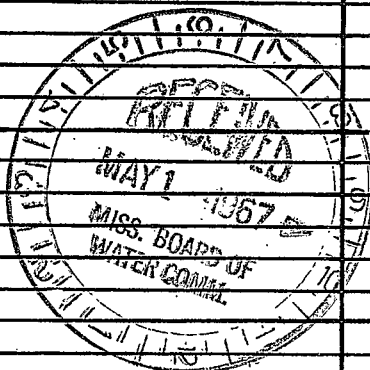

DRILLERS REMARKS:

If well telescopes please sketch and show depths.

GROUND LEVEL

X			

SECTION \_\_\_\_\_

Please indicate well location X.

ADDITIONAL INFORMATION

If more than one screen, show locations of each on sketch.