

UNION  
N35  
7-23-73

MISSISSIPPI  
BOARD OF WATER COMMISSIONERS  
416 North State Street  
Jackson, Mississippi 39201

**CODED**

WATER WELL DRILLERS LOG

June 19 73 J.W. Webb & Son Union  
date well completed firm name county well located

LANDOWNER: Lucian Cole  
Blue Springs

description of formations encountered	from	to
Soil	0	1
Red Sand & Rocks	1	300
Blue Rock	300	491
Water Rock	491	494
Water Sand	494	645
Coffee sand		

(mailing address)

WELL LOCATION:

sec. 18 T. 85 N R. 4 E  
4 miles south of Blue Springs  
(distance) (direction) (nearest town)

WELL PURPOSE:

(home, irrigation, municipal, industrial)

WELL COMPLETION DATA:

- (1) diameter (inches) 4"
- (2) total depth (feet) 645'
- (3) static water level (feet) 250 below top of ground.
- (4) casing steel 402 ft  
(material) (depth)  
4" (size) if telescope see back.
- (5) screen 0 (length) 0 (depth to top)  
0 (size) 0 (material)
- (6) pump 3/4 HP Sub 7 (yield gpm)  
E. Lee (type power)
- (7) electric log (yes or no)
- (organization running log)
- (8) how well bottom plugged

**CODED**



DRILLERS REMARKS:

Pure pipe in Bottom of well

JUL 18 1973

If well telescopes please sketch and show depths.

GROUND LEVEL

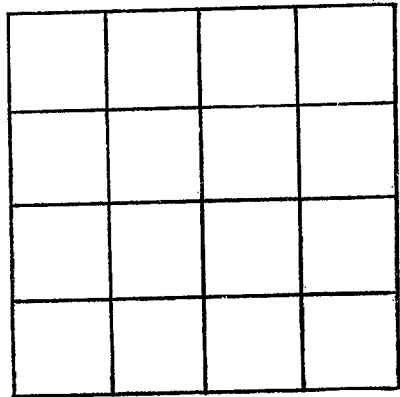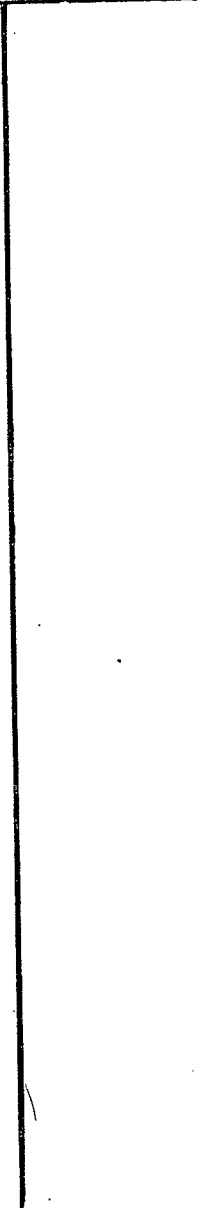

SECTION \_\_\_\_\_

Please indicate well location X.

ADDITIONAL INFORMATION

Lined area for additional information, consisting of approximately 20 horizontal lines.

If more than one screen, show locations of each on sketch.