

UNION
N 37
11-14-74

MISSISSIPPI
 BOARD OF WATER COMMISSIONERS
 416 North State Street
 Jackson, Mississippi 39201

CODED

WATER WELL DRILLERS LOG

11-14 1974 Bond Well Drilling Union
 date well completed firm name county well located

LANDOWNER: Jessie Deibel
Blue Springs
Miss
 (mailing address)

description of formations encountered	from	to
Red clay	0	30
Blue clay	30	30.5
Water Sand	31.5	36.5

WELL LOCATION:
 sec. 1 T. 8 N. R. 4 E.
4 miles NE of Blue Springs
 (distance) (direction) (nearest town)

WELL PURPOSE: Home
 (home, irrigation, municipal, industrial)

- WELL COMPLETION DATA:
- (1) diameter (inches) 4"
 - (2) total depth (feet) 36.5
 - (3) static water level (feet) 160 ^{below} top of ground.
 - (4) casing Steel, 36,
 (material) (depth)
 (size) If telescope see back.
 - (5) screen None,
 (length) (depth to top)
 (size) (material)
 - (6) pump 3/4 10
 (HP) (yield gpm)
Sub
 (type power)
 - (7) electric log no
 (yes or no)
 (organization running log)
 - (8) how well bottom plugged Open


CODED

RECEIVED
 MAR 13 1975

DRILLERS REMARKS:

If well telescopes please sketch and show depths.

GROUND LEVEL

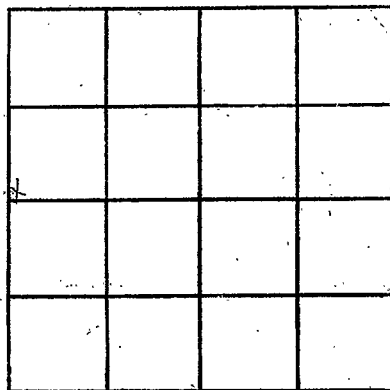

SECTION _____

Please indicate well location X.

ADDITIONAL INFORMATION

If more than one screen, show locations of each on sketch.