


(X)

If well telescopes please sketch and show depths.

44

GROUND LEVEL

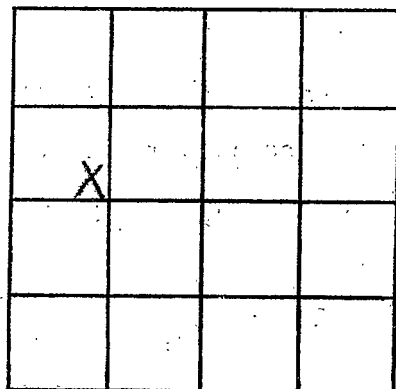

SECTION 10

Please indicate well location X.

ADDITIONAL INFORMATION

44

832 - 863
 863 - 890

Top Lap
764'

Bottom casing
832'

Bottom Blank
880'

Bottom Screen
921'

Top Screen
832
 Top Blank
863
 63

If more than one screen, show locations of each on sketch.