

UNION
 N 2001
 4-19-76

MISSISSIPPI
 BOARD OF WATER COMMISSIONERS
 416 North State Street
 Jackson, Mississippi 39201

WATER WELL DRILLERS LOG

4-19 1976 J. W. Webb & Sons Union
 date well completed firm name county well located

LANDOWNER: Mrs. Elvin Howell
 Blue Springs
 (mailing address)

description of formations encountered	from	to
soil	0	1
Hard Clay	1	35
Blue Rock	35	325
Water Rock	325	326
Water Sand	326	420
Coarse Sand		

WELL LOCATION:
 sec. 13 T. 48 N. R. 4 E
 2 1/2 miles N. East of Sherman
 (distance) (direction) (nearest town)

WELL PURPOSE:
 (home, irrigation, municipal, industrial)


- WELL COMPLETION DATA:
- (1) diameter (inches) 5
 - (2) total depth (feet) 430
 - (3) static water level (feet) 184 below top of ground.
 - (4) casing Steel 4 1/2" (material) (depth)
 - (size) if telescope see back.
 - (5) screen 0 (length) 0 (depth to top)
 - (size) (material)
 - (6) pump 1/2 Hask 8 (HP) (yield gpm)
 - Elec (type power)
 - (7) electric log no (yes or no)
 - (organization running log)
 - (8) how well bottom plugged

DRILLERS REMARKS:

UNION
 JUN 23 1976
 MISSISSIPPI BOARD OF WATER COMMISSIONERS

If well telescopes please sketch and show depths.

GROUND LEVEL

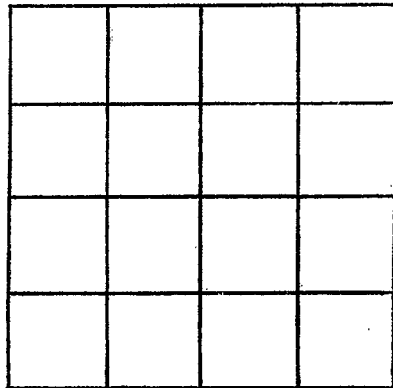

SECTION _____

Please indicate well location X.

ADDITIONAL INFORMATION

If more than one screen, show locations of each on sketch.