

Union
 N 2002
 9-1-76

MISSISSIPPI
 BOARD OF WATER COMMISSIONERS
 416 North State Street
 Jackson, Mississippi 39201

WATER WELL DRILLERS LOG

Sept 1 1976 J. W. Webb Sons Union
 date well completed firm name county well located

LANDOWNER: Wayne Holmes
Sherman Miss

description of formations encountered	from	to
Soil	0	1
Clay + Humus	1	36
Blue Rock	36	278
Water Rock	278	280
Water Sand	280	380
Coppl. Sand		

(mailing address)

WELL LOCATION:
 sec. 13 T. 8 S. N. R. 4 E
3 miles N East of Sherman
 (distance) (direction) (nearest town)

WELL PURPOSE:
 (home, irrigation, municipal, industrial)

WELL COMPLETION DATA:

- (1) diameter (inches) 5
- (2) total depth (feet) 380
- (3) static water level (feet) 177 below above top of ground.
- (4) casing Steel 14-2 1/2"
 (material) (depth)
 _____ if telescope see back.
 (size)
- (5) screen 0 0
 (length) (depth to top)
0 0
 (size) (material)
- (6) pump 3/4 Hissel 10 gal
 (HP) (yield gpm)
Elec
 (type power)
- (7) electric log no
 (yes or no)

 (organization running log)
- (8) how well bottom plugged _____


DRILLERS REMARKS:

RECEIVED
 OCT - 1 1976

MISS. BD. OF WATER COMM.

If well telescopes please sketch and show depths.

GROUND LEVEL

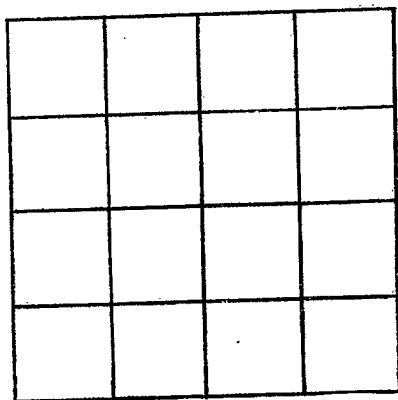

SECTION _____

Please indicate well location X.

ADDITIONAL INFORMATION

Lined area for additional information, consisting of 18 horizontal lines.

If more than one screen, show locations of each on sketch.