

UNION
 N 2003
 5-21-77

MISSISSIPPI
 BOARD OF WATER COMMISSIONERS
 416 North State Street
 15F Jackson, Mississippi 39201

WATER WELL DRILLERS LOG

5-21- date well completed
 Medlin Well Drilling Union firm name
 county well located

LANDOWNER: Camp Armistead
 New Albany Miss. (mailing address)

description of formations encountered	from	to
Clay	0	50
Layer of Clay	50	200
Blue Clay	200	540
Level + Rock	540	650

WELL LOCATION:
 sec. 4 T. 7 N. R. 4 E
 X 1 1/2 miles North of Memphis
 (distance) (direction) (nearest town)

WELL PURPOSE: Church
 (home, irrigation, municipal, industrial)

- WELL COMPLETION DATA:
- (1) diameter (inches) 4
 - (2) total depth (feet) 650
 - (3) static water level (feet) 200 below top of ground
 - (4) casing 4" dia. 650 (material) (depth)
 - (5) screen (size) (length) (depth to top)
 - (6) pump 5 sub. 2.5 (HP) (yield gpm)
 - (7) electric log (yes or no)
 - (8) how well bottom plugged Ph. Cap.


DRILLERS REMARKS:

RECEIVED
 SEP 30 1977

MISSISSIPPI WATER COMMISSION

If well telescopes please sketch and show depths.

GROUND LEVEL

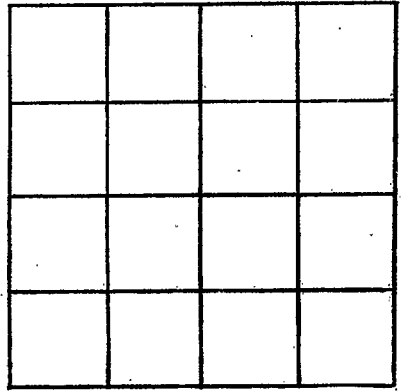

SECTION _____

Please indicate well location X.

ADDITIONAL INFORMATION

If more than one screen, show locations of each on sketch.