

**MISSISSIPPI
BOARD OF WATER COMMISSIONERS**
416 North State Street
Jackson, Mississippi 39201

UNION
N 2004
7-27-77

13C

WATER WELL DRILLERS LOG

July 27 1977 J. W. Webb & Sons Union
date well completed firm name county well located

LANDOWNER: <u>Annemay Miller</u>	description of formations encountered	from	to
<u>Blue Springs</u> (mailing address)	<u>soil</u>	<u>0</u>	<u>1</u>
WELL LOCATION: sec. <u>13</u> T. <u>85</u> N R. <u>4</u> E <u>2.0</u> miles <u>North</u> of <u>Sherman</u> (distance) (direction) (nearest town)	<u>Gravel</u> <u>White Rock</u> <u>Blue Rock</u> <u>Water Rock</u> <u>Water Sand</u> <u>Coffee Sand</u>	<u>1</u> <u>25</u> <u>29</u> <u>29</u> <u>279</u> <u>281</u>	<u>25</u> <u>29</u> <u>29</u> <u>281</u> <u>400</u>
WELL PURPOSE: (home, irrigation, municipal, industrial)			
WELL COMPLETION DATA: (1) diameter (inches) <u>5</u> (2) total depth (feet) <u>400</u> (3) static water level (feet) <u>167</u> below top of ground. (4) casing <u>Steel</u> <u>4 1/2"</u> (material) (depth) <u>5"</u> if telescope see back. (size) (5) screen _____ (length) (depth to top) (size) (material) (6) pump <u>Pod pump 3</u> (HP) (yield gpm) <u>Elec</u> (type power) (7) electric log _____ (yes or no) (organization running log) (8) how well bottom plugged <u>0</u>			
DRILLERS REMARKS:			


RECEIVED

OCT 13 1977

MISS. BD. OF WATER COMMISSIONERS

If well telescopes please sketch and show depths.

GROUND LEVEL

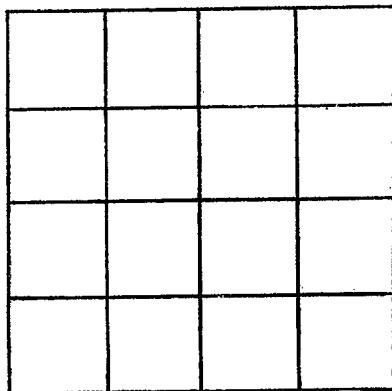

SECTION _____

Please indicate well location X.

ADDITIONAL INFORMATION

If more than one screen, show locations of each on sketch.