

UNION
N 2005
7-28-77

MISSISSIPPI
 BOARD OF WATER COMMISSIONERS
 416 North State Street
 Jackson, Mississippi 39201

13C

WATER WELL DRILLERS LOG

July 28 1977 J. W. Webb & Sons Union
 date well completed firm name county well located


LANDOWNER:	description of formations encountered	from	to
Shaw	Soil	0	1
	Gravel	1	30
(mailing address)	White Rock	30	33
WELL LOCATION:	Blue Rock	33	281
sec. 12 T 86 N R 14 E	Water sand Rock	281	283
S W	Water Sand	283	400
3 1/2 miles with W of Shreveport	Coffee Sand		
(distance) (direction) (nearest town)			
2 MILE E OF BLUE SPRINGS			
WELL PURPOSE:			
(home, irrigation, municipal, industrial)			
WELL COMPLETION DATA:			
(1) diameter (inches) 5"			
(2) total depth (feet) 400			
(3) static water level (feet) 173 below top of ground			
(4) casing Steel 42' (material) (depth)			
(size) If telescope see back.			
(5) screen (length) (depth to top)			
(size) (material)			
(6) pump 1/2 Seal (HP) 8 (yield gpm)			
Elec (type power)			
(7) electric log (yes or no)			
(organization running log)			
(8) how well bottom plugged			
DRILLERS REMARKS:			

RECEIVED
 OCT 13 1977

TER CONTINUED

If well telescopes please sketch and show depths.

GROUND LEVEL

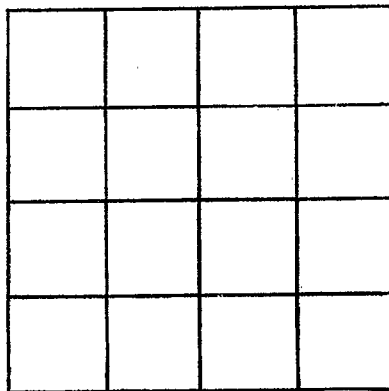

SECTION _____

Please indicate well location X.

ADDITIONAL INFORMATION

A series of horizontal lines for recording additional information, starting below the 'ADDITIONAL INFORMATION' header and extending to the bottom of the page.

If more than one screen, show locations of each on sketch.