

**MISSISSIPPI
BOARD OF WATER COMMISSIONERS**
416 North State Street
Jackson, Mississippi 39201

WATER WELL DRILLERS LOG

Union
Lee
N 2006
10/7/77

Union
Lee

Oct 7 1977
date well completed

J. W. Webb & Sons
firm name

county well located


| LANDOWNER: <u>Banner Long</u> | description of formations encountered | from | to |
|--|---------------------------------------|------------|------------|
| <u>Blue Springs</u> (mailing address) | <u>Soil</u> | <u>0</u> | <u>1</u> |
| WELL LOCATION: sec. <u>5</u> T <u>8S</u> N R <u>5</u> E S W | <u>Clay + Shale</u> | <u>1</u> | <u>28</u> |
| <u>3</u> miles <u>East</u> of <u>Blue Springs</u> (distance) (direction) (nearest town) | <u>Blue Rock</u> | <u>28</u> | <u>135</u> |
| WELL PURPOSE: (home, irrigation, municipal, industrial) | <u>Water Rock</u> | <u>135</u> | <u>136</u> |
| WELL COMPLETION DATA: (1) diameter (inches) <u>5</u> | <u>Water sand</u> | <u>136</u> | <u>240</u> |
| (2) total depth (feet) <u>240</u> | <u>Coarse sand</u> | | |
| (3) static water level (feet) <u>60</u> below above top of ground. | | | |
| (4) casing <u>Steel</u> , <u>4.3'</u> (material) (depth) | | | |
| <u>5"</u> (size) if telescope see back. | | | |
| (5) screen <u>0</u> <u>0</u> (length) (depth to top) | | | |
| <u>0</u> <u>0</u> (size) (material) | | | |
| (6) pump <u>1/2 HP</u> <u>5</u> (HP) (yield gpm) | | | |
| <u>Elco</u> (type power) | | | |
| (7) electric log <u>no</u> (yes or no) | | | |
| (organization running log) | | | |
| (8) how well bottom plugged | | | |
| DRILLERS REMARKS: | | | |

RECEIVED

OCT 13 1977

If well telescopes please sketch and show depths.

GROUND LEVEL

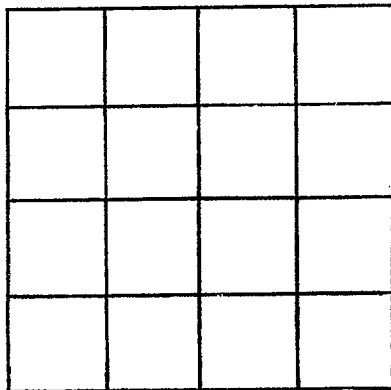

SECTION _____

Please indicate well location X.

ADDITIONAL INFORMATION

If more than one screen, show locations of each on sketch.